

(9)

WATER WELL DRILLERS LOG

PANOLA

J
4-3-62

J. B. CAIN

Date: 4-3-62, 1962, Driller: J. B. CAIN, County: PANOLA

(Name)

(1) Owner of Land:	Description & Color of Materials Sand, Clay, Red Clay, Shell, etc.	Thick- ness Feet	Depth Feet
MR HAZE D. HAZE (Name) FACE SHARIS LAKE	Clay Sand	30	30
(Address)			
(2) Location: 1/4, 1/4, Sec. T R			
15 N E SHARIS			
miles of (distance) (direction) (Nearest Town)			
(3) Topography:			
(Hilly) LAKE CAIN (Flat) (Level)			
(4) Purpose of Well:			
(Domestic Irrigation Municipal, Industrial, Other)			


Information upon completion of well:

- (1) Diameter 2 inches.
- (2) Total Depth 90 feet.
- (3) Water Level 70 feet below top of ground. 90 2"
- (4) Cased to 1 1/2, Size 5 FT
- (5) Screen: Size, Length
- (6) Were any formations sealed against pollution?
yes, no.

If YES depth of formation

Why

Drillers Remarks:

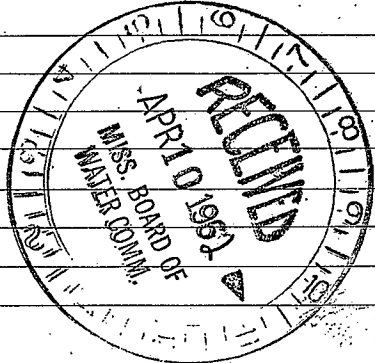

(Use Back Side)

Well No.

