


J
8-12-63

WATER WELL DRILLERS LOG

Date: 8-12, 1963, Driller: J B CAIN County: Panola
(Name)

(1) Owner of Land: <u>Mrs Mary Gite</u> <u>Sardis Miss</u> (Name) (Address)	Description & Color of Materials Sand, Clay, Red Clay, Shell, etc.	Thick- ness Feet	Depth Feet
(2) Location: <u>1/4</u> , <u>1/4</u> , Sec. <u>T</u> <u>R</u> <u>9</u> miles <u>East</u> of <u>Sardis</u> (distance) (direction) (Nearest Town)	<u>Sand</u>	<u>0</u>	<u>65</u>
(3) Topography: _____ (Hilly) (Flat) (Level)			
(4) Purpose of Well: _____ (Domestic Irrigation Municipal, Industrial, Other)			
Information upon completion of well:			
(1) Diameter <u>2"</u> inches.			
(2) Total Depth <u>65</u> feet.			
(3) Water Level <u>55</u> feet below top of ground.			
(4) Cased to <u>65</u> , Size <u>2"</u>			
(5) Screen: Size <u>3</u> , Length <u>5</u> <u>Plastic well + screen</u>			
(6) Were any formations sealed against pollution? _____ yes, _____ no.			
If YES depth of formation _____			
Why _____			
Drillers Remarks: _____			
_____ _____ _____			

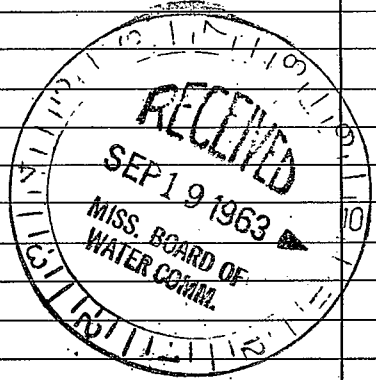

(Use Back Side)

Well No.

