

PANOLA

MISSISSIPPI BOARD OF WATER COMMISSIONERS

J
6-1-65

WATER WELL DRILLERS LOG

Date: 6-1, 1965, Driller: Jerry Robinson County Panola
(Name)

(1) Owner of Land: Mr Bagitt
(Name)
Sardis, Miss
(Address)

(2) Location: 1/4, 1/4, Sec. T. R., Hayes crossing
14 miles East, of Sardis
(distance) (direction) (Nearest Town)

(3) Topography:
(Hilly) (Flat) (Level)

(4) Purpose of Well: Home
(Domestic Irrigation
Municipal, Industrial, Other)

Description & Color of Materials Sand, Clay, Red Clay, Shell, etc.	Thick- ness Feet	Depth Feet
<u>Clay</u>	<u>0</u>	<u>20</u>
<u>Sand</u>	<u>20</u>	<u>30</u>
<u>Black Clay</u>	<u>30</u>	<u>80</u>
<u>Sandy Clay</u>	<u>80</u>	<u>110</u>
<u>Sand</u>	<u>110</u>	<u>127</u>

Information upon completion of well:

(1) Diameter 2 inches.

(2) Total Depth 127 feet.

(3) Water Level 80 feet below top of ground.

(4) Cased to 122, Size 2,


(5) Screen: Size 3, Length 5 ft.

(6) Were any formations sealed against pollution?
 yes, no.

If YES depth of formation

Why

Drillers Remarks: Plastic well

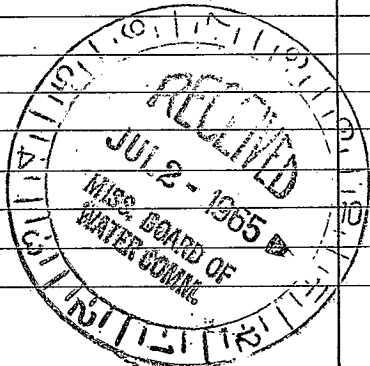

(Use Back Side)

Well No.

