

PANOLA
J2
8-4-71

MISSISSIPPI
BOARD OF WATER COMMISSIONERS
416 North State Street
Jackson, Mississippi 39201

Bolser

WATER WELL DRILLERS LOG **CODED**

8-4 1971 Job Carr Panola
date well completed firm name county well located

LANDOWNER: BoDWen

description of formations encountered	from	to
---------------------------------------	------	----

(mailing address)

WELL LOCATION:
sec. 25 T 7 N R 6 E
8 miles E of SARDIS
(distance) (direction) (nearest town)

Sand + Sand Stone	0	29
Blue Clay + Sand Stone	29	47
Sand	47	60
Clay + Sand Stone	60	97

WELL PURPOSE:
(home, irrigation, municipal, industrial)

Sand	97	120
------	----	-----

WELL COMPLETION DATA:

- (1) diameter (inches) 4"
- (2) total depth (feet) 228
- (3) static water level (feet) 100 below above
top of ground.
- (4) casing PLASTIC, 228,
(material) (depth)
 if telescope see back.
(size)
- (5) screen 6, 222
4" (length) (depth to top)
 , PLASTIC
(size) (material)
- (6) pump 3/4 10
(HP) (yield gpm)
FLC
(type power)
- (7) electric log
(yes or no)

Sand + Clay streak	120	130
Water Sand	130	228

CODED

(organization running log)

(8) how well bottom plugged West Bottom


MAY 20 1972

MISS. BD. OF
WATER COMMISSIONERS

DRILLERS REMARKS:

If well telescopes please sketch and show depths.

GROUND LEVEL

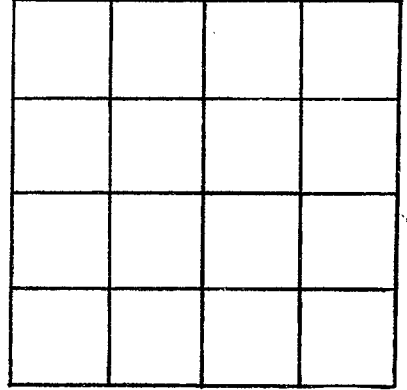

SECTION _____

Please indicate well location X.

ADDITIONAL INFORMATION

If more than one screen, show locations of each on sketch.