

Big Stream Well Drilling Co -

MISSISSIPPI
BOARD OF WATER COMMISSIONERS
416 North State Street
Jackson, Mississippi 39201

PANOLA

J4

3-5-74

CODED

WATER WELL DRILLERS LOG

March 5 1974 J B Cain Panola
date well completed firm name county well located

LANDOWNER: Mr Parker
Comoe Mills

description of formations encountered	from	to
Clay	10	60
Sand	60	90

(mailing address)

WELL LOCATION:

sec. 7 T. 7 N. R. 5 E
10 miles E of Comoe
(distance) (direction) (nearest town)

WELL PURPOSE:

(home, irrigation, municipal, industrial)

WELL COMPLETION DATA:

- (1) diameter (inches) 4"
- (2) total depth (feet) 90
- (3) static water level (feet) 30 below above top of ground.
- (4) casing Plastic 90 (material) (depth)
(size) if telescope see back.
- (5) screen 18' 80 (length) (depth to top)
4" PLASTIC (size) (material)
- (6) pump 3/4 11 (HPY) (yield gpm)
S.P. (type power)
- (7) electric log no (yes or no)

(organization running log)

(8) how well bottom plugged Plug


DRILLERS REMARKS:

REGISTERED
APR 26 1974

MISS. Bd. OF WATER COMMISSIONERS

If well telescopes please sketch and show depths.

GROUND LEVEL

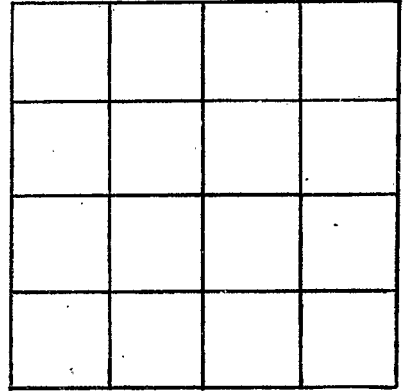

SECTION _____

Please indicate well location X.

ADDITIONAL INFORMATION

If more than one screen,
show locations of each on sketch.