

15 E

PANOLA  
55  
9-1-68

MISSISSIPPI  
BOARD OF WATER COMMISSIONERS  
416 North State Street  
Jackson, Mississippi 39201

CODED CODED  
CODED

WATER WELL DRILLERS LOG

9-1-1968 date well completed  
Bob Smith Well firm name  
Panola county well located

LANDOWNER: Magles

description of formations encountered

from to

Cono, Miss.  
(mailing address)

top soil 0 5  
red clay 5 20  
red sand 20 40  
white sand & clay 40 80  
fine sand 80 130  
coarse white sand 130 160

WELL LOCATION:

sec. 6 T 1 N R 5 E  
S  
12 miles E of Cono  
(distance) (direction) (nearest town)

WELL PURPOSE: None  
(home, irrigation, municipal, industrial)

CODED

WELL COMPLETION DATA:

- (1) diameter (inches) 4
- (2) total depth (feet) 160'
- (3) static water level (feet) 100 below top of ground.
- (4) casing P. lastic 160'  
(material) (depth)

CODED

(size) If telescope see back.

- (5) screen 20 140  
(length) (depth to top)  
4 P. lastic  
(size) (material)

- (6) pump 34 10  
(HP) (yield gpm)

Elec.  
(type power)

- (7) electric log no  
(yes or no)

(organization running log)

- (8) how well bottom plugged plugged

NOV 25 1968


DRILLERS REMARKS:

MISS. BD. OF  
WATER COM.

good drilling

If well telescopes please sketch and show depths.

GROUND LEVEL

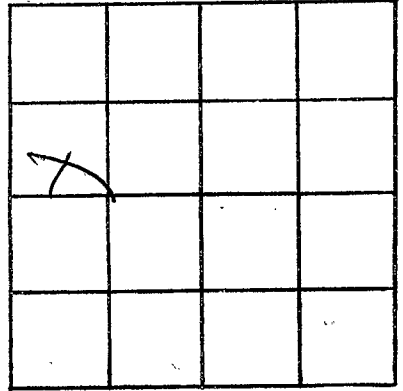

SECTION \_\_\_\_\_

Please indicate well location X.

ADDITIONAL INFORMATION

If more than one screen, show locations of each on sketch.