

Panola  
J 1  
6-22-70

MISSISSIPPI  
 BOARD OF WATER COMMISSIONERS  
 416 North State Street  
 Jackson, Mississippi 39201

**CODED**

WATER WELL DRILLERS LOG

6-22 1970 James R Lipe Panola  
 date well completed firm name county well located

LANDOWNER: Mr. Fleming  
Batesville Miss  
 (mailing address)

description of formations encountered	from	to
Clay	0	20
sand and clay	20	40
" " "	40	60
sand	60	80
" "	80	100
" "	100	120

WELL LOCATION:  
 sec. 16 T 7 N R 5 E  
12 miles east of Batesville  
 (distance) (direction) (nearest town)

WELL PURPOSE: home  
 (home, irrigation, municipal, industrial)

WELL COMPLETION DATA:

- (1) diameter (inches) 4
- (2) total depth (feet) 120
- (3) static water level (feet) 80 below top of ground.
- (4) casing PVC 110  
 (material) (depth)  
4 If telescope see back.  
 (size)
- (5) screen 10 110  
 (length) (depth to top)  
4 PVC  
 (size) (material)
- (6) pump 1/2 12  
 (HP) (yield gpm)  
elec.  
 (type power)
- (7) electric log no  
 (yes or no)  
no  
 (organization running log)
- (8) how well bottom plugged PVC  
plug

**CODED**


JUL 10 1970

MISS. BD. OF  
 WATER COMM.

DRILLERS REMARKS:

If well telescopes please sketch and show depths.

GROUND LEVEL

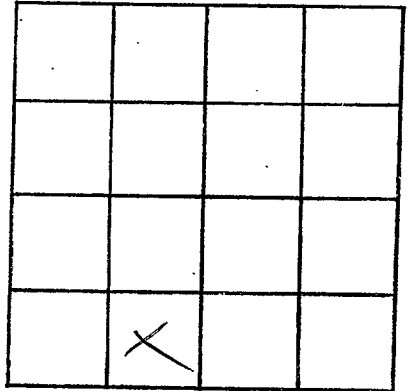

SECTION 16

Please indicate well location X.

ADDITIONAL INFORMATION

If more than one screen,  
show locations of each on sketch.