

MISSISSIPPI
BOARD OF WATER COMMISSIONERS
416 North State Street
Jackson, Mississippi 39201

CODED

PANOLA
J 8
7-11-70

WATER WELL DRILLERS LOG

July 17 1970 Shell Nezman Panola
date well completed firm name county well located

LANDOWNER: <u>Hays Brothers & Hall</u>	description of formations encountered	from	to
<u>Sardis, Miss.</u> (mailing address)			
	<u>Red clay</u>	<u>0</u>	<u>70</u>
	<u>Gravel</u>	<u>20</u>	<u>40</u>
WELL LOCATION: sec. <u>19</u> T. <u>7</u> R. <u>5</u> <u>12</u> miles <u>E</u> of <u>Sardis</u> (distance) (direction) (nearest town)	<u>White clay</u>	<u>40</u>	<u>70</u>
	<u>White sand</u>	<u>70</u>	<u>90</u>

WELL PURPOSE: Home
(home, irrigation, municipal, industrial)

WELL COMPLETION DATA:

- (1) diameter (inches) 2
- (2) total depth (feet) 90
- (3) static water level (feet) 60 below top of ground.
- (4) casing Galvanized 84
(material) (depth)
- 1 1/2 if telescope see back.
(size)
- (5) screen 5 90
(length) (depth to top)
- 1 1/2 58
(size) (material)
- (6) pump 1 6
(HP) (yield gpm)
- Electric
(type power)
- (7) electric log no
(yes or no)
- no
(organization running log)
- (8) how well bottom plugged Rubber Seal

CODED


AUG 17 1970

DRILLERS REMARKS: This well at Richard Whittaker's cabin on Sardis Lake land lot leased from Hays Brothers & Hall Plantation

MISS. Bd. of
WATER COMMISSIONERS

If well telescopes please sketch and show depths.

GROUND LEVEL

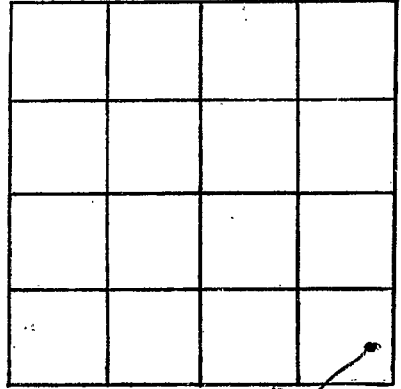

well

SECTION 19

Please indicate well location X.

ADDITIONAL INFORMATION

If more than one screen, show locations of each on sketch.