

PANOLA
 J10
 11-20-74

MISSISSIPPI
 BOARD OF WATER COMMISSIONERS
 416 North State Street
 Jackson, Mississippi 39201

CODED

WATER WELL DRILLERS LOG

11-20 date well completed
 1974 Life Well Co. firm name
 Panola county well located

LANDOWNER: Jack Davis
 Como
 Miss.
 (mailing address)

WELL LOCATION:
 sec. 7 T 7 N R 5 E
 6 miles east of Como
 (distance) (direction) (nearest town)

description of formations encountered	from	to
TOPSOIL	0	20
red sand	20	40
clay	40	60
white sand	60	80
	80	100
	100	143

WELL PURPOSE:
 (home, irrigation, municipal, industrial)

WELL COMPLETION DATA:

(1) diameter (inches) 4

(2) total depth (feet) 143

(3) static water level (feet) 50 below top of ground.

(4) casing PVC 133 (material) (depth)
 4 (size) if telescope see back.

(5) screen 10 133 (length) (depth to top)
 4 PVC (size) (material)

(6) pump 3/4 10 (HP) (yield gpm)
 elec. (type power)

(7) electric log NO (yes or no)
 NO (organization running log)

(8) how well bottom plugged PVC CAP


CODED

REGISTERED
 DEC 5 1974

DRILLERS REMARKS:

If well telescopes please sketch and show depths.

GROUND LEVEL

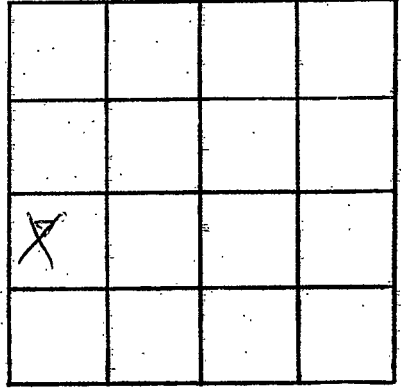

SECTION 2

Please indicate well location X.

ADDITIONAL INFORMATION

Lined area for additional information.

If more than one screen, show locations of each on sketch.