

Panola  
 J 2000  
 2-25-76

MISSISSIPPI  
 BOARD OF WATER COMMISSIONERS  
 416 North State Street  
 Jackson, Mississippi 39201

15F

WATER WELL DRILLERS LOG

2-25-76 date well completed 19 76 Live Well Co. firm name Panola county well located

LANDOWNER:  
 Bennie Manual  
 Como Miss.  
 (mailing address)

description of formations encountered	from to	
Top Soil	0	20
Sand	20	160
Clay	160	180
White Sand	180	200

WELL LOCATION:  
 sec. 6 T 7 N R. 85 E  
 10 miles east of Como  
 (distance) (direction) (nearest town)

WELL PURPOSE:  
 (home, irrigation, municipal, industrial)

WELL COMPLETION DATA:

(1) diameter (inches) 4

(2) total depth (feet) 200

(3) static water level (feet) 160 below top of ground.

(4) casing PVC 190 (material), (depth)

4 (size) If telescope see back.

(5) screen 10 190 (length), (depth to top)

4 PVC (size), (material)

(6) pump 3/4 10 (HP), (yield gpm)

elec (type power)

(7) electric log NO (yes or no)

NO (organization running log)


(8) how well bottom plugged PVC CAP

DRILLERS REMARKS:

RECEIVED  
 MAR 4 1976

If well telescopes please sketch and show depths.

GROUND LEVEL

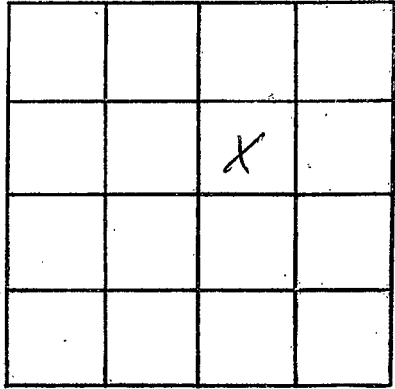

SECTION 6

Please indicate well location X.

ADDITIONAL INFORMATION

If more than one screen,  
show locations of each on sketch.