

PANOLA
 J 2001
 3-15-76

MISSISSIPPI
 BOARD OF WATER COMMISSIONERS
 416 North State Street
 Jackson, Mississippi 39201

WATER WELL DRILLERS LOG

March 13 1976 North Miss Well Dri Panola
 date well completed firm name county well located

LANDOWNER: H.B. Morat
 1550 N Parkway
 Memphis Tenn
 (mailing address)


description of formations encountered	from	to
Clay & Striated Sand	0	135
Sand	135	150

WELL LOCATION:
 sec 20 T 7 N R 5 E
 9 miles S of Sardi's
 (distance) (direction) (nearest town)

WELL PURPOSE: Home
 (home, irrigation, municipal, industrial)

- WELL COMPLETION DATA:
- (1) diameter (inches) 4"
 - (2) total depth (feet) 150
 - (3) static water level (feet) 40 below top of ground.
 - (4) casing Plastic, 150 (material) (depth)
 - (size) If telescope see back.
 - (5) screen 10' 140 (length) (depth to top)
 - 4" Plastic Slot (size) (material)
 - (6) pump 1/2 13 (HP) (yield gpm)
 - Elex (type power)
 - (7) electric log 200 (yes or no)
 - (organization running log)
 - (8) how well bottom plugged Plug

DRILLERS REMARKS:

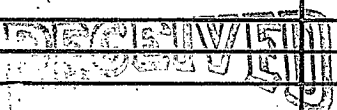

APR 20 1976

