

PANOLA
DJ 2002
5-17-76

MISSISSIPPI
BOARD OF WATER COMMISSIONERS
416 North State Street
Jackson, Mississippi 39201

WATER WELL DRILLERS LOG


May 17 1976 ^{15F} Walth Miss Well Drilling Parola
date well completed firm name county well located

LANDOWNER:	description of formations encountered	from	to
Shanville Heckler Tackle Bot	Sand, Clay Strake	0	70
(mailing address)	Sand	70	160
WELL LOCATION: sec. <u>4</u> T. <u>7</u> N. R. <u>3</u> E. S. <u>2</u> W. <u>2</u>			
(distance) miles (direction) of (nearest town)			
WELL PURPOSE: (home, irrigation, municipal, industrial)			
WELL COMPLETION DATA:			
(1) diameter (inches) <u>4</u>			
(2) total depth (feet) <u>100</u>			
(3) static water level (feet) <u>70</u> below above top of ground.			
(4) casing <u>Plastic</u> (material) <u>100</u> (depth)			
(size) If telescope see back.			
(5) screen <u>10</u> (length) (depth to top)			
<u>4"</u> (size) <u>Hot Plastic</u> (material)			
(6) pump <u>1/2</u> (HP) <u>10</u> (yield gpm)			
<u>Eloc</u> (type power)			
(7) electric log <u>no</u> (yes or no)			
(organization running log)			
(8) how well bottom plugged <u>Plug</u>			
DRILLERS REMARKS:			

MISS. Bd. of Water Comm.
JUN 11 1976
COMM

If well telescopes please sketch and show depths.

GROUND LEVEL

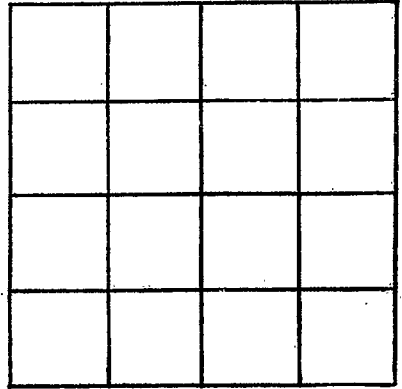

SECTION _____

Please indicate well location X.

ADDITIONAL INFORMATION

If more than one screen, show locations of each on sketch.