

Panola
 J 2005
 6/30/77

MISSISSIPPI
 BOARD OF WATER COMMISSIONERS
 416 North State Street
 Jackson, Mississippi 39201

WATER WELL DRILLERS LOG

6-30-77 19 P.R. Mason Water Well Driller Panola
 date well completed firm name county well located


LANDOWNER:	description of formations encountered	from	to
W.W. Brantley Memphis Tenn. (mailing address)			
WELL LOCATION:	Red sand	18	50
sec. <u>5</u> T <u>7</u> N R. <u>5</u> E <u>10</u> miles <u>SE</u> of <u>Como</u> (distance) (direction) (nearest town)	white sand	50	80
WELL PURPOSE: <u>Home</u> (home, irrigation/municipal, industrial)	white clay	80	180
WELL COMPLETION DATA:	white sand	180	215
(1) diameter (inches) <u>4"</u>			
(2) total depth (feet) <u>228'</u>			
(3) static water level (feet) <u>138'</u> below top of ground			
(4) casing <u>Plaster</u> <u>205'</u> (material) (depth) <u>4"</u> if telescope see back. (size)			
(5) screen <u>10'</u> <u>205'</u> (length) (depth to top) <u>4"</u> <u>Plaster</u> (size) (material)			
(6) pump <u>3/4</u> <u>10</u> (HP) (yield gpm) <u>electric</u> (type power)			
(7) electric log <u>No</u> (yes or no)			
(organization running log)			
(8) how well bottom plugged <u>cap</u>			
DRILLERS REMARKS:			

RECEIVED
 DEC 12 1977


MISS. BD. OF WATER COMM

If well telescopes please sketch and show depths.

GROUND LEVEL

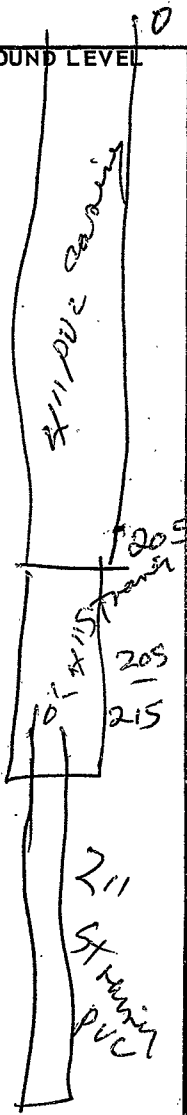

N

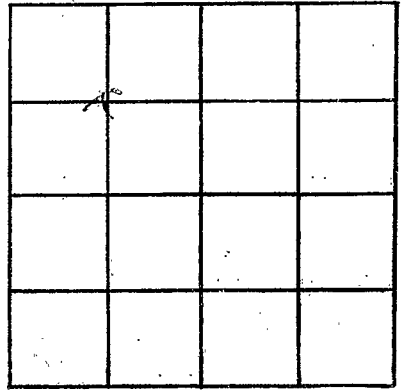

SECTION 5

Please indicate well location X.

ADDITIONAL INFORMATION

If more than one screen, show locations of each on sketch.