

PANOLA
J 2007

**MISSISSIPPI
BOARD OF WATER COMMISSIONERS**
416 North State Street
Jackson, Mississippi 39201

WATER WELL DRILLERS LOG

4-27-1978 Rich Well Co Panola
 date well completed firm name county well located

LANDOWNER: Sam Watson Paul
Rt. 1, Box 409
Sardin, Mo.
 (mailing address)

WELL LOCATION:
 sec. 19 T. 7 N. R. 5 E. S. 5
 (distance) (direction) (nearest town)

WELL PURPOSE: Home
 (home, irrigation, municipal, industrial)

description of formations encountered	from	to
Red clay	0	15
White Clay	15	70
Black Clay	70	115
Heavy Crossing Sand + Clay	115	140
White Sand	140	155

WELL COMPLETION DATA:

(1) diameter (inches) 4

(2) total depth (feet) 155

(3) static water level (feet) 60 below above top of ground.

(4) casing PVC 155
 (material) (depth)

_____ if telescope see back.
 (size)

(5) screen 7' 148'
 (length) (depth to top)

4" gravel type
 (size) (material)

(6) pump 1/2 10
 (HP) (yield gpm)

220V
 (type power)

(7) electric log No
 (yes or no)

_____ (organization running log)

(8) how well bottom plugged Cap


RECEIVED
 MAY 30 1978

DRILLERS REMARKS: _____

MISS. BD. OF WATER COMM

If well telescopes please sketch and show depths.

GROUND LEVEL

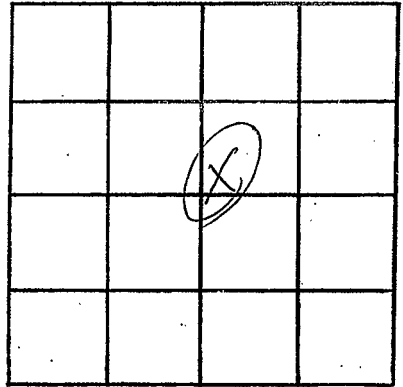

SECTION _____

Please indicate well location X.

ADDITIONAL INFORMATION

If more than one screen,
show locations of each on sketch.