

PANOLA

J 2009

6/8/78

MISSISSIPPI BOARD OF WATER COMMISSIONERS
416 North State Street
Jackson, Mississippi 39201

WATER WELL DRILLERS LOG

6-8 1978 Hicks Well Co Panola
date well completed firm name county well located


LANDOWNER:	description of formations encountered	from	to
<u>Charles Turner</u>			
<u>5206 Thimewood</u>	<u>Red Sand</u>	<u>0</u>	<u>40</u>
<u>Memphis, Tenn.</u> (mailing address)	<u>White Clay & Sand</u>	<u>40</u>	<u>130</u>
WELL LOCATION:	<u>White Sand</u>	<u>130</u>	<u>168</u>
sec. <u>19</u> T. <u>7</u> N. R. <u>5</u> E. S. <u>5</u> W.			
<u>1</u> miles (distance) <u>W</u> (direction) of <u>Haype Crossing</u> (nearest town)			
WELL PURPOSE: <u>Home</u> (home, irrigation, municipal, industrial)			
WELL COMPLETION DATA:			
(1) diameter (inches) <u>4</u> 7			
(2) total depth (feet) <u>168</u>			
(3) static water level (feet) <u>140</u> below top of ground.			
(4) casing <u>PVC</u> (material) <u>168</u> (depth)			
(size) If telescope see back.			
(5) screen <u>2</u> (length) <u>161</u> (depth to top)			
<u>4</u> (size) <u>gravel type</u> (material)			
(6) pump <u>42</u> (HP) <u>18</u> (yield gpm)			
<u>220V</u> (type power)			
(7) electric log <u>No</u> (yes or no)			
(organization running log)			
(8) how well bottom plugged <u>Cap</u>			
DRILLERS REMARKS:			

RECEIVED

JUN 29 1978

If well telescopes please sketch and show depths.

GROUND LEVEL

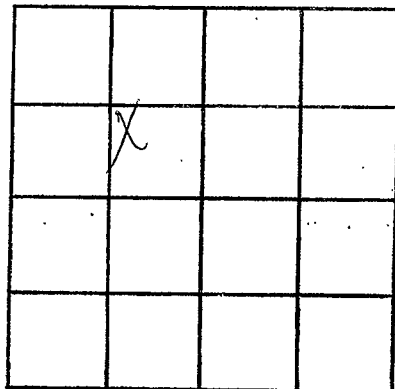

SECTION 19

Please indicate well location X.

ADDITIONAL INFORMATION

If more than one screen,
show locations of each on sketch.