

PANOLA

J 2010

8-22-78

MISSISSIPPI
 BOARD OF WATER COMMISSIONERS
 416 North State Street
 Jackson, Mississippi 39201

WATER WELL DRILLERS LOG

Hicks Well Co

8-22-1978
date well completed

Hicks Well Co
firm name

PANOLA
county well located

LANDOWNER: Wayne Massey

description of formations encountered

from to

Rt. 1

Red clay

0 15

COMO MISS

Red sand

15 90

(mailing address)

White sand

90 145

WELL LOCATION:

?-22B T 7 N R 6 E
 4 miles S of Clenvel
 (distance) (direction) (nearest town)

WELL PURPOSE: Dom
 (home, irrigation, municipal, industrial)

WELL COMPLETION DATA:

- (1) diameter (inches) 4"
- (2) total depth (feet) 145
- (3) static water level (feet) 90 below top of ground.
- (4) casing PVC, 145,
 (material) (depth)

_____ if telescope see back.
(size)

- (5) screen 7', 7'
 (length) (depth to top)

4", INSIDE ROCK
 (size) (material)

- (6) pump 3/11 10
 (HP) (yield gpm)


220 Elec
 (type power)

- (7) electric log _____
 (yes or no)

_____ (organization running log)

- (8) how well bottom plugged C&P


DRILLERS REMARKS:

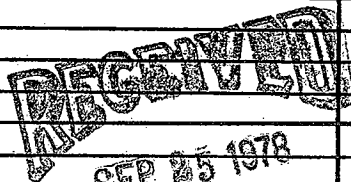

MISS. Bd. OF WATER COMM.

If well telescopes please sketch and show depths.

GROUND LEVEL

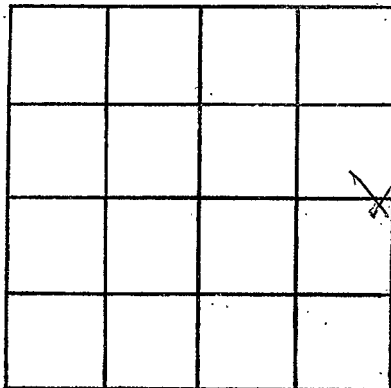

SECTION _____

Please indicate well location X.

ADDITIONAL INFORMATION

If more than one screen,
show locations of each on sketch.