

MISSISSIPPI DEPARTMENT OF NATURAL RESOURCES

Bureau of Land and Water Resources

Southport Mall

P.O. Box 10631

Jackson, Mississippi 39209

WATER WELL DRILLERS LOG

PANOLA
J 2001
5-11-81

5-11 1981 Hicks Well Co. Panola
 date well completed firm name county well located

LANDOWNER: Jr. D. Shelly
709 Rosebank
Memphis, TN
 (mailing address)

WELL LOCATION:
 sec. 19 T 2 N R. 5 E
 (S) (W)
1 miles (distance) of Harper Creek (direction) of Harper Creek (nearest town)

WELL PURPOSE: Home
 (home, irrigation, municipal, industrial)

WELL COMPLETION DATA:

- (1) diameter (inches) 4
- (2) total depth (feet) 185
- (3) static water level (feet) 120 below above top of ground.
- (4) casing PVC 185
 (material) (depth)
1 if telescope see back.
 (size)
- (5) screen 12 173
 (length) (depth to top)
2 1/2" Gravel & PVC
 (size) (material)
- (6) pump 1/2 10
 (HP) (yield gpm)
220V
 (type power)
- (7) electric log No
 (yes or no)
 (organization running log)
- (8) how well bottom plugged Cap


description of formations encountered	from	to
Red sand	0	25
Rock	25	26
White clay	26	65
Black Clay	65	115
White sand & clay	115	160
White sand	160	185



DRILLERS REMARKS:

If well telescopes please
sketch and show depths.

GROUND LEVEL

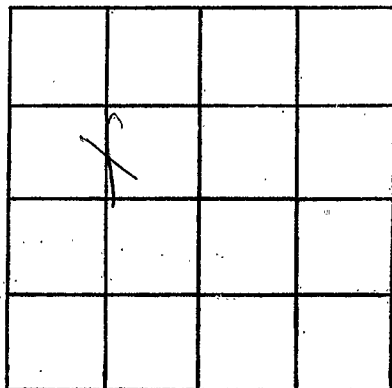

SECTION 19

Please indicate well location X.

ADDITIONAL INFORMATION

If more than one screen,
show locations of each on sketch.