

MISSISSIPPI DEPARTMENT OF NATURAL RESOURCES

Bureau of Land and Water Resources

Southport Mall

P.O. Box 10631


Jackson, Mississippi 39209

WATER WELL DRILLERS LOG

Parola
J 2012
7-15-81

7-15 1981 Hicks Well Co. Parola
 date well completed firm name county well located

LANDOWNER: <u>Louis Knight</u>	description of formations encountered	from	to
(mailing address)			
<u>Memphis Tn.</u>	<u>Red Clay</u>	<u>0</u>	<u>20</u>
WELL LOCATION: sec. <u>19</u> T. <u>9</u> N. R. <u>5</u> E. <u>S</u> <u>W</u>	<u>Brown Clay & Sand</u>	<u>20</u>	<u>125</u>
(distance) miles (direction) of <u>Hope Crossing</u> (nearest town)	<u>Rock</u>	<u>125</u>	<u>126</u>
WELL PURPOSE: <u>Home</u> (home, irrigation, municipal, industrial)	<u>White Clay</u>	<u>126</u>	<u>140</u>
WELL COMPLETION DATA:	<u>White Sand</u>	<u>140</u>	<u>170</u>
(1) diameter (inches) <u>4</u>			
(2) total depth (feet) <u>170</u>			
(3) static water level (feet) <u>100</u> below above top of ground.			
(4) casing <u>PVC</u> , <u>170</u> , (material) (depth) (size) If telescope see back.			
(5) screen <u>12</u> , <u>158</u> (length) (depth to top) <u>4"</u> <u>gravel + PVC</u> (size) (material)			
(6) pump <u>1/2</u> , <u>10</u> (HP) (yield gpm) <u>220V</u> (type power)			
(7) electric log <u>No</u> (yes or no)			
(organization running log)			
(8) how well bottom plugged <u>Cap</u>			

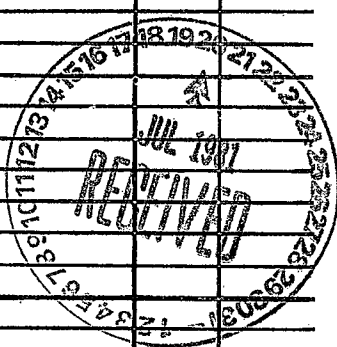

DRILLERS REMARKS:

