

MISSISSIPPI DEPARTMENT OF NATURAL RESOURCES

Bureau of Land and Water Resources

Southport Mall

P.O. Box 10631

Jackson, Mississippi 39209

WATER WELL DRILLERS LOG

Parola
J2014

Parola

4-22 1982
 date well completed

HICKS WELL COMPANY

RT. 1 - BOX 1077
 firm name

county well located

| LANDOWNER: <u>Josephine Whitney</u> | | description of formations encountered | from | to |
|--|--|---------------------------------------|------------|------------|
| <u>Bo. 1</u> | | | | |
| <u>Cano, Miss. 38619</u> (mailing address) | | <u>Red clay</u> | <u>0</u> | <u>20</u> |
| WELL LOCATION: | | <u>Red sand</u> | <u>20</u> | <u>80</u> |
| sec. <u>8</u> T <u>7</u> N R <u>5</u> E | | <u>Rock</u> | <u>80</u> | <u>81</u> |
| <u>2 1/2</u> miles <u>S</u> of <u>Blenville</u> | | <u>Brown clay</u> | <u>81</u> | <u>135</u> |
| (distance) (direction) (nearest town) | | <u>Rock</u> | <u>135</u> | <u>136</u> |
| WELL PURPOSE: <u>Home</u> (home, irrigation, municipal, industrial) | | <u>Brown clay</u> | <u>136</u> | <u>160</u> |
| WELL COMPLETION DATA: | | <u>White sand</u> | <u>160</u> | <u>195</u> |
| (1) diameter (inches) <u>4</u> | | | | |
| (2) total depth (feet) <u>195</u> | | | | |
| (3) static water level (feet) <u>100</u> below above top of ground. | | | | |
| (4) casing <u>PVC</u> , <u>195</u> (material) (depth) | | | | |
| <u> </u> if telescope see back. (size) | | | | |
| (5) screen <u>15</u> , <u>180</u> (length) (depth to top) | | | | |
| <u>08</u> , <u>PVC</u> (size) (material) | | | | |
| (6) pump <u>1/2</u> , <u>10</u> (HP) (yield gpm) | | | | |
| <u>220V</u> (type power) | | | | |
| (7) electric log <u>No</u> (yes or no) | | | | |
| <u> </u> (organization running log) | | | | |
| (8) how well bottom plugged <u>Cap</u> | | | | |

DEPT. OF NATURAL RESOURCES
 BUREAU OF LAND & WATER RESOURCES


MAY 10 1982

RECEIVED

DRILLERS REMARKS:

If well telescopes please sketch and show depths.

GROUND LEVEL

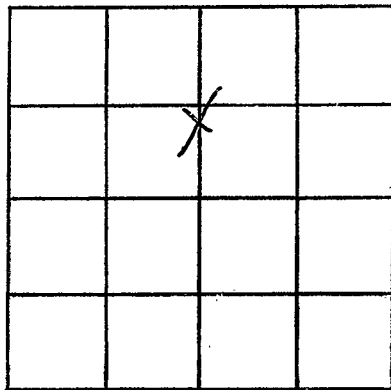

SECTION 8

Please indicate well location X.

ADDITIONAL INFORMATION

If more than one screen, show locations of each on sketch.