

MISSISSIPPI DEPARTMENT OF NATURAL RESOURCES

Bureau of Land and Water Resources

Southport Mall

P.O. Box 10631

Jackson, Mississippi 39209

WATER WELL DRILLERS LOG

Panola  
2015  
J

date well completed 6-2-1982 HICKS WELL COMPANY name Panola county well located

LANDOWNER: <u>Dodie Ricard</u>	description of formations encountered	from	to
<u>Rt 1 Box 310</u>			
<u>Comms 38619</u> (mailing address)	<u>Red Clay</u>	<u>0</u>	<u>28</u>
<b>WELL LOCATION:</b>	<u>Red Sand</u>	<u>20</u>	<u>50</u>
sec. <u>10</u> T. <u>7</u> N R. <u>5</u> E	<u>White Sand + Clay</u>	<u>20</u>	<u>175</u>
<u>3</u> miles <u>SW</u> of <u>Helm</u>	<u>White Sand</u>	<u>175</u>	<u>230</u>
(distance) (direction) (nearest town)			
<b>WELL PURPOSE:</b> <u>HOME</u> (home, irrigation, municipal, industrial)			
<b>WELL COMPLETION DATA:</b>			
(1) diameter (inches) <u>4</u>			
(2) total depth (feet) <u>230</u>			
(3) static water level (feet) <u>100</u> below above top of ground.			
(4) casing <u>PVC</u> , <u>230</u> , (material) (depth)			
<u>        </u> if telescope see back. (size)			
(5) screen <u>10ft</u> , <u>220</u> (length) (depth to top)			
<u>0.10</u> , <u>PVC</u> (size) (material)			
(6) pump <u>1/2</u> , <u>10</u> (HP) (yield gpm)			
<u>220V</u> (type power)			
(7) electric log <u>NO</u> (yes or no)			
<u>        </u> (organization running log)			
(8) how well bottom plugged <u>cap</u>			

DEPT. OF NATURAL RESOURCES  
 BUREAU OF LAND & WATER RESOURCES


JUN 14 1982

RECEIVED

DRILLERS REMARKS:

If well telescopes please sketch and show depths.

GROUND LEVEL

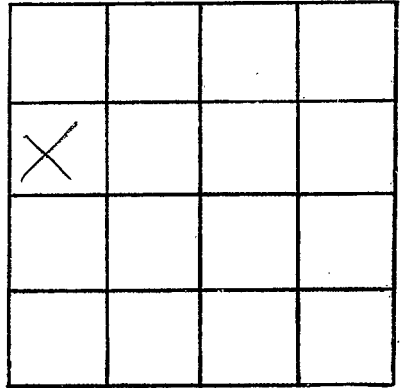

SECTION 60

Please indicate well location X.

ADDITIONAL INFORMATION

If more than one screen,  
show locations of each on sketch.