

MISSISSIPPI DEPARTMENT OF NATURAL RESOURCES

Bureau of Land and Water Resources

Southport Mall

P.O. Box 10631

Jackson, Mississippi 39209

WATER WELL-DRILLERS LOG

HICKS WELL CO.

P.O. Box 157

Stuttgart, MS 39368

Panola
8 2016

Panola

12/9 19 83
date well completed

county well located

LANDOWNER: Leonard Bass

description of formations encountered

from

to

Rt. 1

Sanders, Ms. 38666

(mailing address)

WELL LOCATION:

sec. 18 T. 7 N. R. 5 E. of Hughes County
(distance) miles (direction) (nearest town)

Red Clay

0 20

Red Sand

20 35

white clay

35 50

Black Clay

50 170

white Sand

170 205

WELL PURPOSE:

Home
(home, irrigation, municipal, industrial)

WELL COMPLETION DATA:

- (1) diameter (inches) 4
- (2) total depth (feet) 205
- (3) static water level (feet) 140 below top of ground.
- (4) casing PVC, 205
(material) (depth)
4" if telescope see back.
(size)
- (5) screen 10', 195'
(length) (depth to top)
1010, PVC
(size) (material)
- (6) pump 3/4, 10
(HP) (field gpm)
220V
(type power)
- (7) electric log No
(yes or no)

(organization running log)

(8) how well bottom plugged Caf

DEPT. OF NATURAL RESOURCES
BUREAU OF LAND & WATER RESOURCES


JAN 9 - 1984

RECEIVED

DRILLERS REMARKS:

If well telescopes please sketch and show depths.

GROUND LEVEL

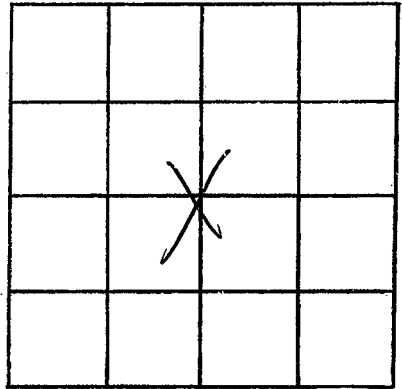

SECTION 18

Please indicate well location X.

ADDITIONAL INFORMATION

If more than one screen,
show locations of each on sketch.