

MISSISSIPPI DEPARTMENT OF NATURAL RESOURCES

Bureau of Land and Water Resources

Southport Mall

P.O. Box 10631

Jackson, Mississippi 39209

WATER WELL DRILLERS LOG

PANOLA  
J  
2017

date well completed 10-9 1988

HICKS WELL COMPANY

RT. 130 Box 157

Panola  
county well located

LANDOWNER: Shirley Brewer  
P.O. Box 153  
Landia, MS 38666  
(mailing address)

description of formations encountered	from	to
<u>Red clay</u>	<u>0</u>	<u>10</u>
<u>Red sand</u>	<u>10</u>	<u>50</u>
<u>Black clay</u>	<u>50</u>	<u>185</u>
<u>White sand</u>	<u>185</u>	<u>215</u>

WELL LOCATION:  
sec. 20 T. 7 N. R. 5 E. S. 5 W.  
14 miles SE of Como  
(distance) (direction) (nearest town)

WELL PURPOSE: Road  
(home, irrigation, municipal, industrial)



WELL COMPLETION DATA:

- (1) diameter (inches) 4"
- (2) total depth (feet) 215'
- (3) static water level (feet) 20' below above top of ground.
- (4) casing PVC, 205'  
(material) (depth)  
4"  
(size) if telescope see back.
- (5) screen 10', 205'  
(length) (depth to top)  
.013, PVC  
(size) (material)
- (6) pump 1/2, 10  
(HP) (yield gpm)  
220V  
(type power)
- (7) electric log NO  
(yes or no)

(organization running log)

(8) how well bottom plugged Cap

DRILLERS REMARKS:

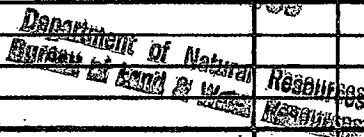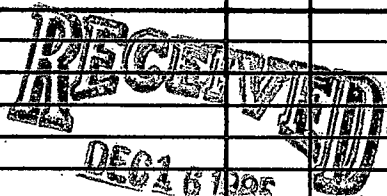

If well telescopes please sketch and show depths.

GROUND LEVEL



If more than one screen, show locations of each on sketch.

X			

SECTION 20

Please indicate well location X.

ADDITIONAL INFORMATION

