

**MISSISSIPPI DEPARTMENT OF ENVIRONMENTAL QUALITY**  
Bureau of Land and Water Resources

P. O. Box 10631  
Jackson, MS 39289-0631  
**WATER WELL DRILLERS LOG**

COUNTY WELL LOCATED <i>PANOLA</i>	
WELL NUMBER <i>J 20</i>	CODED <i>24</i>
DATE WELL COMPLETED <i>5-7-91</i>	

PERMIT NUMBER <b>HICKS WELL CO.</b>
NAME OF DRILLING FIRM <b>RT. 1 BOX 157 SENATOBIA, MS 38668</b>

NAME & MAILING ADDRESS OF LANDOWNER <i>Donald Chadwich</i>		
<i>3843 Tutwiler Ave</i>		
<i>Memphis TN 38122</i>		
WELL LOCATION: SEC	TOWNSHIP	RANGE
<i>2</i>	<i>7</i>	<i>S 5 E</i>
DISTANCE	DIRECTION	NEAREST TOWN
<i>18</i> Miles	<i>E</i> of	<i>Como</i>
OTHER LANDMARK		
WELL PURPOSE: <input checked="" type="checkbox"/> Home Irrigation, Municipal, Industrial, Fish Pond, etc.		

<b>PUMP DATA</b>		
PUMP TYPE (Circle One): <input checked="" type="checkbox"/> Submersible, Turbine, Jet, Flowing Well, Other (Describe) _____		
POWER TYPE (Circle One): <input checked="" type="checkbox"/> Electric, Tractor, Diesel, Gasoline, Butane, Other (Describe) _____ H/P <i>1/2</i>		
Pump Capacity (GPM)	No. of Stages	Setting Depth
<i>10</i>	<i>9</i>	<i>130</i> FT.
PUMP TEST		
Well yielded <i>10</i> GPM with a drawdown of _____ ft. after _____ hours of pumping		

<b>WELL DATA</b>		
Well Depth <i>150</i>	Casing Diameter (In.) <i>4</i>	Casing Length (Ft.) <i>140</i>
Type of Casing <i>PVC</i>	Hole Depth <i>150</i>	Depth to Static Water Level <i>100</i>
TYPE OF COMPLETION: (Circle One or More): <input checked="" type="checkbox"/> Gravel Packed, Underreamed, Telescoped, Natural Development, Open Hole, Other (Describe) _____		
Top of Lap Pipe or Reduction in Casing		
FEET	IF TELESCOPED OR MORE THAN ONE SCREEN: USE BACK PAGE	

<b>LOG DATA</b>	
TYPE OF LOG RUN (Circle One): No Log Run, Electric, Gamma Ray, Density, Sonic, Neutron, Other (Describe) _____	
Name of Organization Running Log	


<b>SCREEN DATA</b>		
Diameter - Inches <i>4</i>	Length - Feet <i>10</i>	Slot Size - Inches <i>013</i>
Screen Type <i>PVC</i>	Depth to Bottom - Feet <i>10</i>	

<b>GEOLOGIC DATA (Office Use Only)</b>			
Surface Elev.	Geologic Unit	Unit Thickness	Depth to Top
Subs. SWL	Date	Analysis	Aquifer Test
Driller's Remarks			

DESCRIPTION OF FORMATIONS ENCOUNTERED	FROM	TO	FORMATIONS (Continued)	FROM	TO
			<b>RECEIVED</b>		
<i>Dirt</i>	<i>0</i>	<i>15</i>			
<i>Clay</i>	<i>15</i>	<i>90</i>			
<i>Sand</i>	<i>90</i>	<i>150</i>			
			<b>MAY 14 1991</b>		
			Dept. of Environmental Quality Bureau of Land & Water Resources		
			IF MORE SPACE IS NEEDED, USE BACK		

If well telescopes please  
sketch and show depths.

GROUND LEVEL

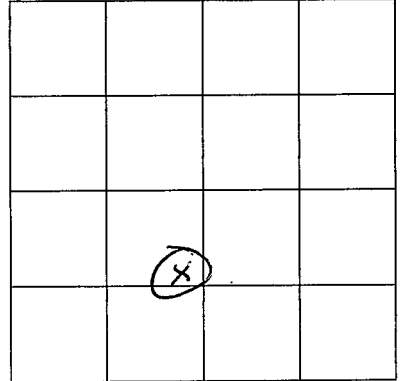

SECTION \_\_\_\_\_

Please indicate well location X.

ADDITIONAL INFORMATION

If more than one screen,  
show location of each on sketch.