

#2

PANOLA
K6
9-10-76

MISSISSIPPI
BOARD OF WATER COMMISSIONERS
416 North State Street
Jackson, Mississippi 39201

CODED

WATER WELL DRILLERS LOG

date well completed sep 10 1976 firm name North Mississippi Well Drilling Panola county well located Panola

LANDOWNER: <u>Willie Gisher</u>	description of formations encountered	from	to
	<u>Clay</u>	<u>0</u>	<u>85</u>
(mailing address)	<u>Sand</u>	<u>15</u>	<u>63</u>
WELL LOCATION: sec. <u>29</u> T <u>8</u> N R. <u>9</u> E <u>5</u> miles <u>E</u> of <u>Doak</u> (distance) (direction) (nearest town)	<u>Sand</u>	<u>63</u>	<u>102</u>
WELL PURPOSE: (home, irrigation) municipal, industrial			
WELL COMPLETION DATA:			
(1) diameter (inches) <u>8"</u>			
(2) total depth (feet) <u>102</u>			
(3) static water level (feet) <u>10</u> below top of ground.			
(4) casing <u>Plastic</u> , <u>102</u> (material) (depth)			
(size) If telescope see back.			
(5) screen <u>40'</u> (length) (depth to top)			
<u>8</u> , <u>Slot Plastic</u> (size) (material)			
(6) pump <u>Century 700</u> (HP) (yield gpm)			
<u>Wester Pro</u> (type power)			
(7) electric log <u>no</u> (yes or no)			
(organization running log)			
(8) how well bottom plugged <u>Plug</u>			
DRILLERS REMARKS:			

CODED


RECEIVED
SEP 27 1976

MISS. BD. OF WATER COMMISSIONERS

8

If well telescopes please sketch and show depths.

GROUND LEVEL

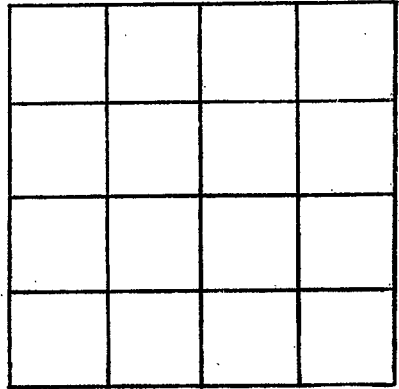

SECTION _____

Please indicate well location X.

ADDITIONAL INFORMATION

If more than one screen, show locations of each on sketch.