

PANOLA

MISSISSIPPI BOARD OF WATER COMMISSIONERS

K 10
10-24-62

WATER WELL DRILLERS LOG

CODED
CODED

Date: 10/24, 1962, Driller: James R. Phine County Panola
(Name)

(1) Owner of Land:	Description & Color of Materials Sand, Clay, Red Clay, Shell, etc.	Thick- ness Feet	Depth Feet
Curtis McNamey (Name)	CLAY	0	20
Sardis, Miss (Address)	CLAY + gravel	20	40
	Gravel	40	50
(2) Location: 1/4, 1/4, Sec. 5 T8 R9 S W	Sand + gravel	50	70
5 miles West of Sardis (distance) (direction) (Nearest Town)	Red Sand	70	90
	Pea gravel	90	105
(3) Topography: Hilly (Hilly) (Flat) (Level)	SAND + gravel	105	140
(4) Purpose of Well: Domestic (Domestic Irrigation Municipal, Industrial, Other)	W/pearing SAND	160	160

Information upon completion of well:

- (1) Diameter 3 inches.
- (2) Total Depth 160 feet.
- (3) Water level 90 feet below top of ground.
- (4) Cased to 153, Size 3
- (5) Screen: Size 2 1/2, Length 6'
- (6) Were any formations sealed against pollution?


yes, no.

If YES depth of formation

Why

Drillers Remarks:

CODED

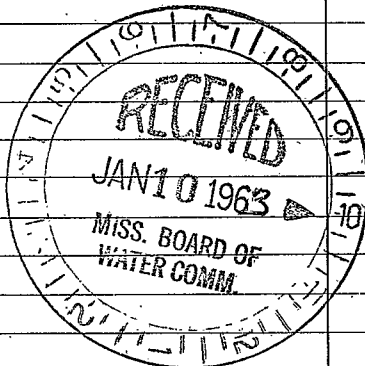

(Use Back Side)

Well No.

1948

1949

1950

1951

1952

1953

1954

1955

1956

1957

1958

1959

1960