

## MISSISSIPPI DEPARTMENT OF NATURAL RESOURCES

Bureau of Land and Water Resources

Southport Mall

P.O. Box 10631

Jackson, Mississippi 39209

## WATER WELL DRILLERS LOG

CODED

Jul. 01

date well completed

19

85 Larrys well &amp; pump Panda

firm name

county well located

LANDOWNER: OTIS JENKINS

description of formations encountered

from

to

Sardis, MS

(mailing address)

clay	0	28
Fine sand	28	56
coarse sand & gravel	56	116

## WELL LOCATION:

sec. 4 T. 8 S. R. 9 E.

(distance) miles (direction) of (nearest town)

## WELL PURPOSE:

(home, irrigation, municipal, industrial)

## WELL COMPLETION DATA:

- (1) diameter (inches) 16"
- (2) total depth (feet) 116
- (3) static water level (feet) 23' below top of ground.
- (4) casing Steel, 76' (material) (depth)

(size) If telescope see back.

- (5) screen 40' 76' (length) (depth to top)
- 16" Steel (size) (material)

- (6) pump 80 1200 (HP) (yield gpm)

DS1 (type power)

- (7) electric log NO (yes or no)

(organization running log)

- (8) how well bottom plugged steel plate

DRILLERS REMARKS:


CODED

RECEIVED  
JUN 22 1966

Department of Natural Resources  
Bureau of Land & Water Resources

If well telescopes please  
sketch and show depths.

GROUND LEVEL

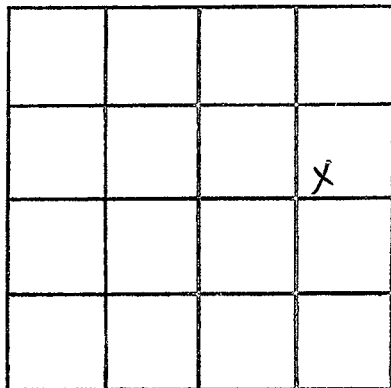

SECTION 4

Please indicate well location X.

ADDITIONAL INFORMATION

If more than one screen,  
show locations of each on sketch.