

MISSISSIPPI DEPARTMENT OF NATURAL RESOURCES

Bureau of Land and Water Resources

Southport Mall

P.O. Box 10631

Jackson, Mississippi 39209

WATER WELL DRILLERS LOG

CODED

PANOLA
K15

July 02 1985 date well completed
 Larry's well & pump firm name
 Panola county well located

LANDOWNER: Otis Jenkins
 Sardis, MS.
 (mailing address)

description of formations encountered	from	to
clay	0	27
Fine sand	27	43
coarse sand & gravel	43	100

WELL LOCATION:
 sec. 5 T 8 N R 9 E
 S S W
 (distance) miles (direction) of (nearest town)

WELL PURPOSE:
 (home, irrigation, municipal, industrial)

WELL COMPLETION DATA:

(1) diameter (inches) 16"

(2) total depth (feet) 100'

(3) static water level (feet) 25' below top of ground.

(4) casing steel, 60' (material) (depth)

(size) If telescope see back.

(5) screen 40' 60' (length) (depth to top)
 16" steel (size) (material)


(6) pump ~~10~~ 3000 (HP) (yield gpm)
 DSI 80 1200 (type power)

(7) electric log No (yes or no)

(organization running log)

(8) how well bottom plugged Steel Plate

CODED

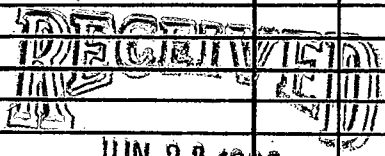


Department of Nat. Resources
 Bureau of Land & Water Resources

DRILLERS REMARKS:

If well telescopes please sketch and show depths.

GROUND LEVEL

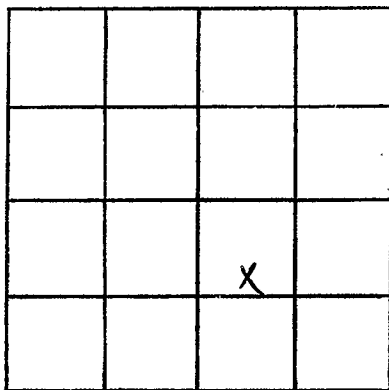

SECTION 5

Please indicate well location X.

ADDITIONAL INFORMATION

If more than one screen, show locations of each on sketch.