

MISSISSIPPI DEPARTMENT OF NATURAL RESOURCES

Bureau of Land and Water Resources

Southport Mall

P.O. Box 10631

Jackson, Mississippi 39209

WATER WELL DRILLERS LOG PANOLA

STANTON
PANOLA
K16
7/86

CODED

7/86 19 date well completed

Powell & Son firm name

Attamas county well located

LANDOWNER:	description of formations encountered	from	to
Otis Jenkins			
Bateaville, MS (mailing address)	Coarse sand & gravel	23	105

WELL LOCATION:
 sec 22 T 8 N R 9 E
5 miles N of Curtis
 (distance) (direction) (nearest town)

WELL PURPOSE: DM
 (home, irrigation, municipal, industrial)

WELL COMPLETION DATA:

(1) diameter (inches) 12

(2) total depth (feet) 105

(3) static water level (feet) 13 below above top of ground.

(4) casing steel, 65,
 (material) (depth)

(size) if telescope see back.

(5) screen 40, 65
 (length) (depth to top)

12, steel
 (size) (material)

(6) pump 60 1200
 (HP) (yield gpm)

diesel
 (type power)

(7) electric log No
 (yes or no)

(organization running log)

(8) how well bottom plugged plugged

CODED

RECEIVED
 10/27/86


OCT 27 1986

Department of Natural Resources
 Bureau of Land & Water Resources

DRILLERS REMARKS:
86204 MGS-04

If well telescopes please sketch and show depths.

GROUND LEVEL

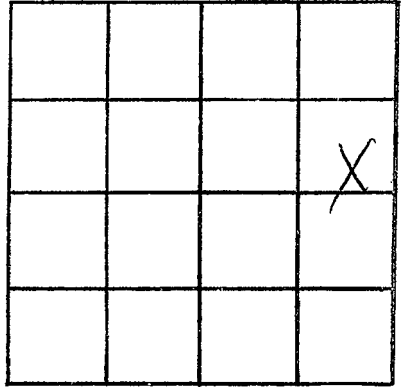

SECTION 22

Please indicate well location X.

ADDITIONAL INFORMATION

If more than one screen,
show locations of each on sketch.