

COTED

PANOLA
K 22

MISSISSIPPI
BOARD OF WATER COMMISSIONERS
416 North State Street
Jackson, Mississippi 39201

563-
565-6

WATER WELL DRILLERS LOG

3-18-92
date well completed

Lips Well Supply
firm name

Panola
county well located

LANDOWNER: Way Brothers Hall
Rt 2 Box 196
Lardis, Ms 38666
(mailing address)

WELL LOCATION:
sec. 12 T. 8 N. R. 9
13 miles SW of Lardis
(distance) (direction) (nearest town)

WELL PURPOSE:
 (home, irrigation, municipal, industrial)

WELL COMPLETION DATA:
(1) diameter (inches) 10"
(2) total depth (feet) 1127'
(3) static water level (feet) 36 (below above top of ground)
(4) casing Steel 1087'
(material) (depth)
6x3 if telescope see back.
(size)
(5) screen 40' 1087'
(length) (depth to top)
3" SS
(size) (material)
(6) pump 2 40
(HP) (yield gpm)
elec.
(type power)
(7) electric log (yes or no)

description of formations encountered	from	to
top soil, clay	0	20
sand	20	40
sand w/ pea gravel	40	60
sand w/ gas gravel	60	80
sand	80	100
sand about 115' then hard clay	100	120
hard clay w/ few streaks	120	140
clay w/ shell rock about 150'	140	160
clay w/ few streaks	160	180
clay w/ few streaks	180	200
clay at first then sand	200	220
firm about 205-220		
sand for about 6'	220	240
back to clay		
Shell rock - 25'		
streak of clay then clay and sand to 250'	240	260
then back to clay		
clay w/ streaks of sand	260	280
hard sand 5'		
sand about 9' then few streaks of clay	280	300
last 3'		
fine sand mixed w/ some clay	300	320
fine sand mixed w/ clay	320	340
" " "	340	360
" " "	360	380
Mixed clay at bottom		
" " "	380	400
sand w/ streaks of clay mixed		
" " "	400	420
" " "	420	440
" " "	440	460
" " "	460	480
sand w/ some streaks	480	500
" " "	500	520
" " "	520	540

LOWER WILCOX

RECEIVED
flow well bottom plugged


DRILLERS REMARKS:

If well telescopes please sketch and show depths.

GROUND LEVEL

cont'd

560-580 - sand w/ streaky clay
 580-600 - sand & clay mixed rock about 587' back sand & clay
 600-620 - sand & clay mixed mostly sand
 620-640 - sand w/ streak or two of clay
 640-660 - sand w/ some clay
 660-680 - sand mostly w/ little clay
 680-700 - sand mostly
 700-720 - " "
 720-740 - " "
 740-760 - little sand then clay
 760-780 - mostly clay w/ little sand, rock about 766'
 780-800 - clay
 800-820 - rock about 802' back to clay
 820-840 - clay
 840-860 - clay
 860-880 - clay w/ little sand
 880-900 clay w/ little sand
 shell rock 886, shell rock 890'
 900-920 - clay, rock 903'
 clay, shell rock 918'
 920-940 - clay, rock 939'
 940-960 - clay
 960-980 - clay
 980-1000 clay
 1000-1020 - clay, rock 1004'
 clay, rock 1015', clay
 1020-1040 clay
 1040-1060 - clay
 1060-1080 - clay
 1080-1100 - mostly clay then sand,
 1090 to 1100 w/ few streaks clay

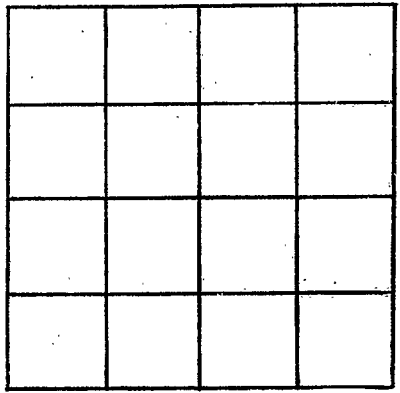

SECTION _____

Please indicate well location X.

ADDITIONAL INFORMATION

1100-1120 - mostly sand w/ few streaks of clay
 1120-1140 - sand w/ few streaks of clay and malinite
 1140-1160 - sand to 1150 shell rock 1151' back to clay
 1160-1180 - clay and some sand mixed

147' 6"

TOP OF 3" LAP - 120' - 1087

If more than one screen, show locations of each on sketch.