

County: Panola
 Permit #: _____
Irrigation Equipment
 Driller: _____
7-13-2011
 Date drilling completed: _____

State Well Report

Part 1 - Driller's Log

Mississippi Department of Environmental Quality
 Office of Land and Water Resources
 P.O. Box 2309
 Jackson, MS 39225
 (601)961-5210
 (601)961-5228 (fax)

For Office Use Only:
 Aquifer: _____
 Well #: 144
 L. S. Elevation: 186
 E-log #: _____

State Law requires that this report be prepared by the license holder responsible for the work and filed with the Department at the above address within 30 days of completion of drilling of the well or borehole.

<p>Information on Well Owner <i>(Landowner if borehole is not for a water well)</i> Owner Name: <u>Grover Lawson</u> Mailing Address: <u>98 Pleasant Grove Rd</u> <u>Sardis MS 38666</u> City State Zip Code Telephone No. () _____</p>	<p>Well or Borehole Location Latitude: <u>34° 24' 43.8N</u> Longitude: <u>90° 06' 51.2W</u> Method of Lat/Long (circle one): <u>Conventional Survey</u> USGS quad, Hand-held GPS, Survey-grade GPS <u>NW</u> 1/4 <u>SE</u> 1/4 Sec <u>2</u> Twn <u>8S</u> Rng <u>9W</u> Distance _____ Miles Direction _____ of Nearest Town _____</p>
---	--

Well / Borehole Data
 Date drilling started: 7-13 Date drilling completed: 7-13 Hole depth: 104 Hole diameter: 24"
 Location of the source of any surface water used for drilling: Surface Water
 Method of dosing and volume of Chlorine used in drilling and development: 50 PPM
 Logs run (circle all applicable): No log run Electric Gamma Ray Density Sonic Neutron Other: _____
 Name of organization running log(s): _____
 Purpose of borehole (check one): Water Well Geotechnical/Geological Investigation _____ Ground Source Heat Pump _____
 Seismic Survey _____ Other (describe) _____
If drilling is not related to water well construction, skip the remainder of this block
 Purpose of Well (check one): Home _____ Industrial _____ Public Supply _____ Irrigation _____ Fish Culture _____ Other: Pivot Replacement GW 13832
 If a flowing well, method of flow regulation: Valve _____ Other (describe) _____
 Static Water Level: _____ feet above or below (circle one) land surface Date measured: _____
 Method of Measurement (circle one) steel tape electric tape air line other: _____
 Well depth: 104 Well grouted to a depth of 10 feet Type of grout (circle one): Neat Cement Bentonite Mix
 Casing length: 64 feet Casing diameter: 16 inches Type of casing: pvc
 Screen length: 40 feet Screen diameter: 16 inches Type of screen: pvc
 Screen slot size: .050 inches Setting depth: From 65 feet to 104 feet
 Type of completion (circle all applicable): Gravel packed Underreamed Telescoped Open hole Natural Development
 Other (describe): _____
 Top of lap pipe or reduction in casing: _____ feet. *If telescoped or more than one screen, describe on next page*

Form: OLWR-SWR-1A (04/08)


Old well 16" steel 45' west of new well
 Circle S Irrigation will install pump.

K 44

The sketch below only required for water wells

If well telescopes, show depths on sketch.

Ground Level \rightarrow

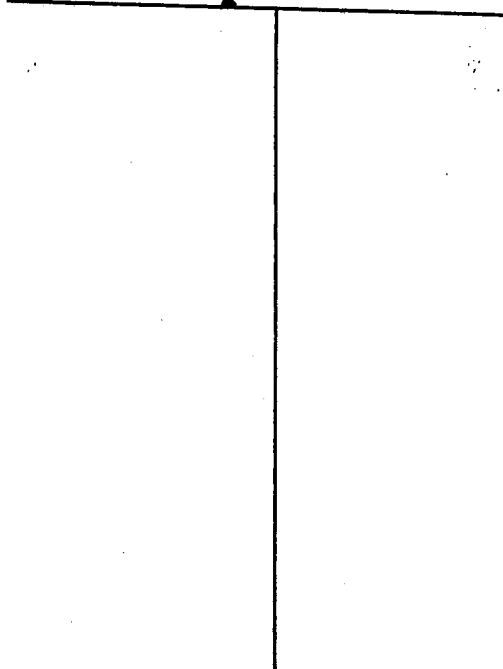

Description of formations encountered must be provided for all wells and boreholes, unless specifically exempted by regulations

Description of Formations Encountered	From (depth)	To (depth)
Clay	Ground Level	22
fine sand	23	33
fine sand & gravel	34	48
med sand & gravel	49	104

If more than one screen, show location of each on sketch

Sketch the property layout and include the following: 1) the well location; 2) any permanent structures on the property that may aid in locating the well; 3) any roads, power lines, or other items that may aid in locating the property and the well; 4) a north arrow.

Landowner Name: Grover Lawson

Form: OLWR-SWR-1A (04/08)

I certify that the well/borehole was drilled, constructed, and completed in accordance with all applicable requirements of the Mississippi Department of Environmental Quality and the Mississippi Department of Health regulations, if applicable, and state laws.


Patrick M. Chism 0695

Print Name of Responsible Licensee and License No.

Date

Signature of Licensee

Panola Co. K44

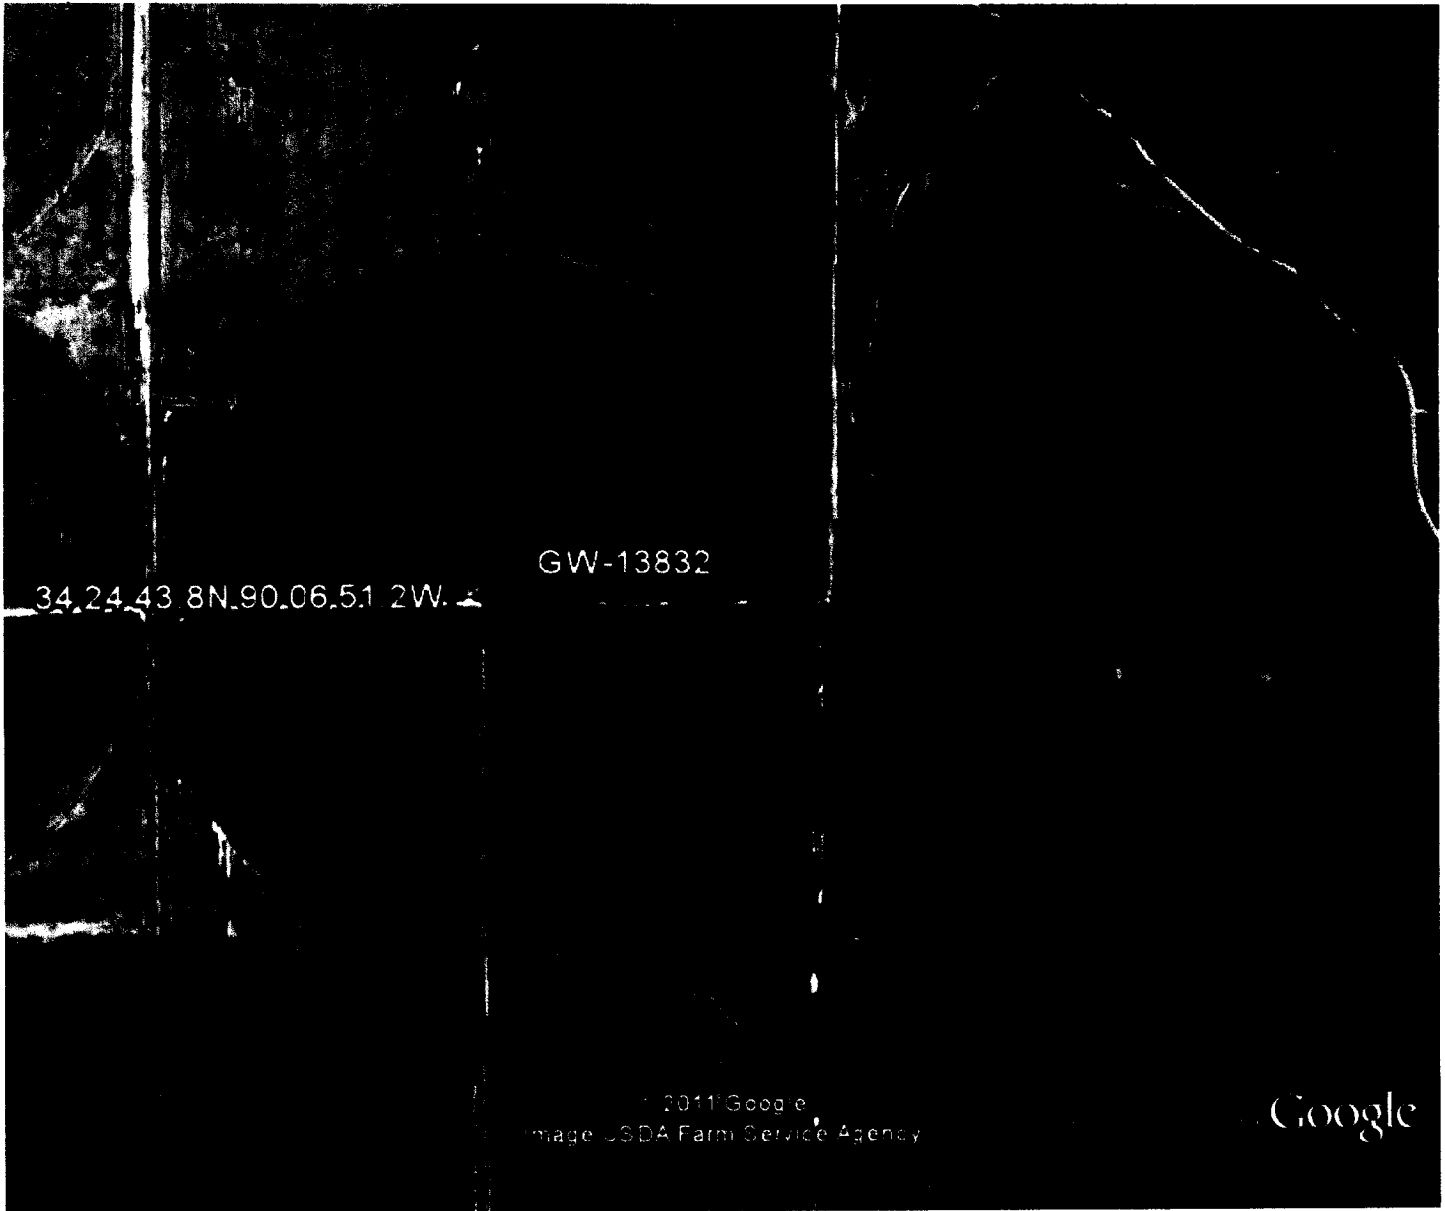

Grover Lawson

Panola County

RECEIVED

SEP 23 2011

2011

STATE WELL REPORT

Part 2

Pump Installer's Completion Report
 Mississippi Department of Environmental Quality
 Office of Land and Water Resources
 P.O. Box 2309
 Jackson, MS 39225
 (601)961-5210
 (601)961-5228 (fax)

County: PANOLA
 Permit #: GW-44073
 Driller: IRRIGATION EQUIPMENT
 Date completed: 7-13-11
Copy information from block on Part 1

For Office Use Only:

Aquifer: KAA
 Well #: _____
 Elevation: _____

This part of the report must be completed by a licensed water well contractor or a licensed pump installer. A copy of Part 1 of the report must be attached and both parts filed with the Department at the above address within 30 days of well completion.

Well Owner Information	Well Location
Owner Name: <u>RIVERSIDE FARMS</u>	Latitude: <u>34° 24' 43.2"</u> Longitude: <u>90° 06' 50.9"</u>
Mailing Address: <u>98 PLEASANT GROVE RD</u>	Method of Lat/Long (check one): Conventional Survey _____
<u>SARDIS</u> <u>MS</u> <u>38666</u>	USGS quad _____, Hand-held GPS _____, Survey-grade GPS _____
City State Zip Code	<u>NW 1/4 SE 1/4 Sec 2 T8S R 9W</u>
Telephone No. <u>(662) 895-5241</u>	Distance Direction Nearest Town <u>1 1/2</u> Miles <u>NW</u> of <u>BALLENTINE</u>

Pump Type Circle one	Power Type Circle one
Air Lift Jet Submersible	<u>Diesel Engine</u> Gasoline Engine Natural Gas
Bucket Piston <u>Turbine</u>	Electric Motor Hand Tractor PTO
Centrifugal Rotary Flowing Well	Windmill Other (specify): _____
Other (specify): _____	Horse Power Rating of Motor: <u>80</u>
Date Pump Installed: <u>9-7-11</u>	Setting Depth: <u>50</u> feet
Rated Pump Capacity: <u>1000</u> Gallons Per Minute	Number of Stages: <u>3</u>

Pump Test Data	Method of Measuring Water Level Circle one
Date Well Tested: _____	Air Line Electric Measuring Line Steel Tape
Static Water Level (A): _____ Feet Below Land Surface	Other (specify): _____
Pumping Water Level (B): _____ Feet Below Land Surface	For flowing well, measured shut in head: _____ feet
Drawdown [(B) - (A)]: _____ Feet Below Land Surface	Well yielded _____ GPM with a drawdown of _____ feet after _____ hours of pumping
Test Pumping Rate: _____ Gallons Per Minute	
Duration of Pump Test (minimum 4 hours): _____ hours	

I HEREBY CERTIFY that the above statements are true to the best of my knowledge.

DAVID P. HOLT 0-752P _____
 Print Name of Pump Installer and License No. (if applicable) Signature of Pump Installer

Form: OLWR-SWR-1B
RECEIVED
 OCT 07 2011
 BY: OLWR