

County: ~~Sardis~~ Panola
 Permit #: MS, GW - 49991
 Driller: TEDDY Coats
 Date drilling completed: 7/18/17

State Well Report
Part 1 - Driller's Log
 Mississippi Department of Environmental Quality
 Office of Land and Water Resources
 P.O. Box 2309
 Jackson, MS 39225
 (601)961-5210
 (601)961-5228 (fax)

For Office Use Only:
 Aquifer: _____
 Well #: K66
 L. S. Elevation: _____
 E-log #: _____

State Law requires that this report be prepared by the license holder responsible for the work and filed with the Department at the above address within 30 days of completion of drilling of the well or borehole.

Information on Well Owner
 (Landowner if borehole is not for a water well)
 Owner Name: Otis Jenkins
 Mailing Address: _____
3364 Holly Grove Road
Sardis MS 38666
 City State Zip Code
 Telephone No. () _____

Well or Borehole Location
 Latitude: 34° 22' 31" Longitude: 90° 10' 1"
 Method of Lat/Long (circle one): Conventional Survey,
 SE USGS quad, Hand-held GPS Survey-grade GPS ✓
NE 1/4 NE 1/4 Sec 20 Twn 08S Rng 09W
 Distance Direction Nearest Town
5 Miles S of Sledge


Well / Borehole Data
 Date drilling started: 7/18/17 Date drilling completed: 7/18/17 Hole depth: 110 Hole diameter: 28
 Location of the source of any surface water used for drilling: Nearest well
 Method of dosing and volume of Chlorine used in drilling and development: _____
 Logs run (circle all applicable): No log run Electric Gamma Ray Density Sonic Neutron Other: _____
 Name of organization running log(s): OLWR
 Purpose of borehole (check one): Water Well Geotechnical/Geological Investigation _____ Ground Source Heat Pump _____
 Seismic Survey _____ Other (describe) _____
If drilling is not related to water well construction, skip the remainder of this block

Purpose of Well (check one): Home _____ Industrial _____ Public Supply _____ Irrigation Fish Culture _____ Other: _____
 If a flowing well, method of flow regulation: Valve _____ Other (describe) _____
 Static Water Level: 20 feet above or below (circle one) land surface Date measured: 7/18/17
 Method of Measurement (circle one) steel tape electric tape air line other: _____
 Well depth: 110 Well grouted to a depth of 10 feet Type of grout (circle one): Neat Cement Bentonite Mix
 Casing length: 70 feet Casing diameter: 16 inches Type of casing: P.V.C
 Screen length: 40 feet Screen diameter: 16 inches Type of screen: P.V.C
 Screen slot size: 0.50 inches Setting depth: From 70 feet to 70 110 feet
 Type of completion (circle all applicable): Travel packed Underreamed Telescoped Open hole Natural Development
 Other (describe): _____
 Top of lap pipe or reduction in casing: _____ feet. *If telescoped or more than one screen, describe on next page*

K66




34 22 31n 90 10 1w
near Crenshaw

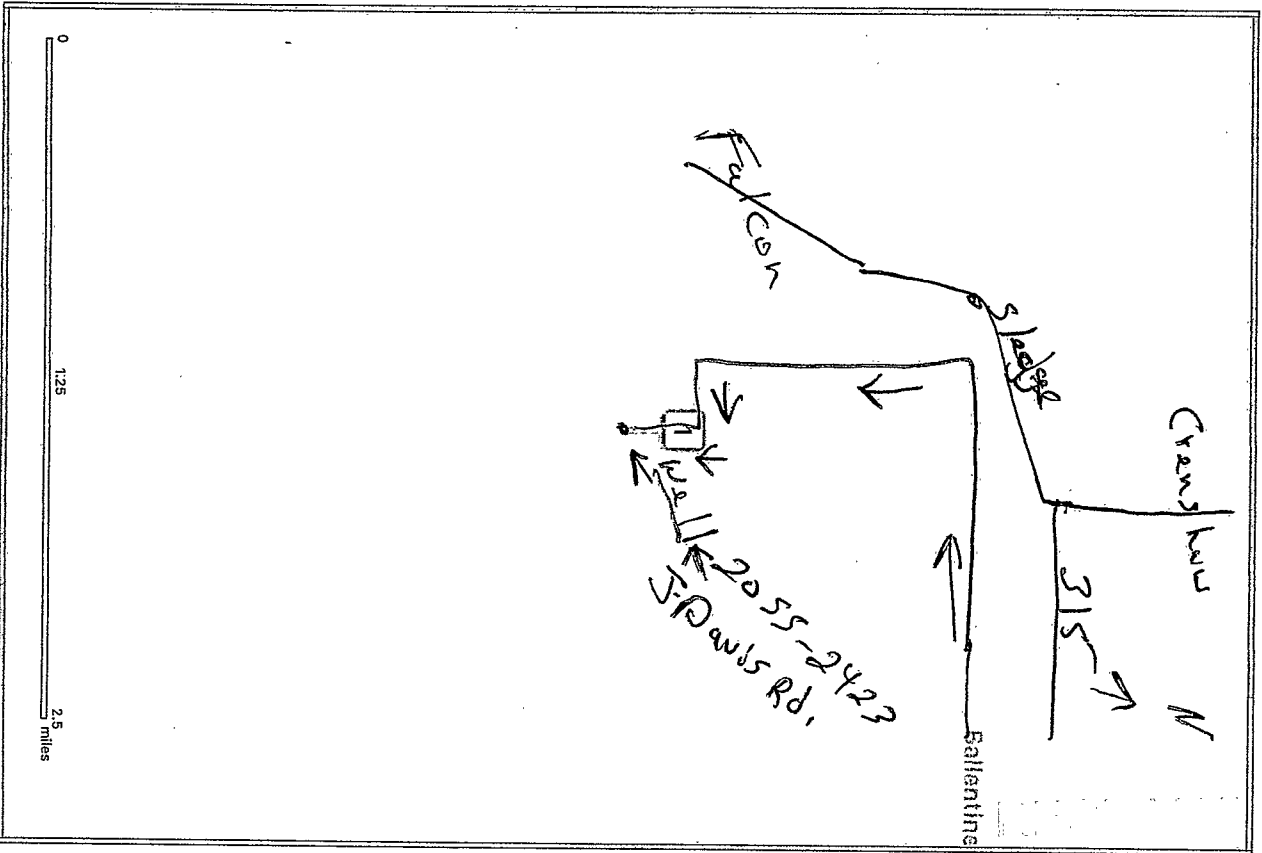

SEP 07 2012

BY OLIVER

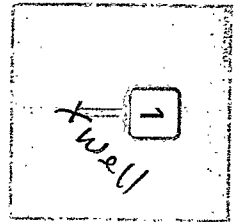

2055-2423 J Davis Rd
2055-2423 J Davis Rd

Panola

STATE WELL REPORT

Part 2

County: ~~Stamps~~
 Permit #: MS 6W-49991
 Driller: TEDDY COATS
 Date completed: 7/18/17
 Copy information from block on Part 1

Pump Installer's Completion Report
 Mississippi Department of Environmental Quality
 Office of Land and Water Resources
 P.O. Box 2309
 Jackson, MS 39225
 (601)961-5210
 (601)961-5228 (fax)

For Office Use Only:
 Aquifer: _____
 Well #: K66
 Elevation: _____

This part of the report must be completed by a licensed water well contractor or a licensed pump installer. A copy of Part 1 of the report must be attached and both parts filed with the Department at the above address within 30 days of well completion.

Well Owner Information	Well Location
Owner Name: <u>otis jenkins</u>	Latitude: <u>34 22 31</u> Longitude: <u>90 10 1</u>
Mailing Address: <u>Same</u>	Method of Lat/Long (check one): Conventional Survey _____
<u>3364 Holly Grove RD</u>	USGS quad _____, Hand-held GPS <input checked="" type="checkbox"/> Survey-grade GPS _____
<u>Sardis MS 38666</u>	<u>NE 1/4 NE 1/4 Sec 20 T.08S R.09W</u>
City State Zip Code	<u>SE</u>
Telephone No. () _____	Distance Direction Nearest Town
	<u>5</u> Miles <u>S</u> of <u>Slagle</u>

Pump Type Circle one	Power Type Circle one
Air Lift Jet Submersible	<u>Diesel Engine</u> Gasoline Engine Natural Gas
Bucket Piston <u>Turbine</u>	Electric Motor Hand <u>SEP 07 2017</u> Tractor PTO
Centrifugal Rotary Flowing Well	Windmill Other (specify): <u>OLWR</u>
Other (specify): _____	Horse Power Rating of Motor: <u>60 HP</u>
Date Pump Installed: <u>7/18/17</u>	Setting Depth: <u>80</u> feet
Rated Pump Capacity: <u>2500</u> Gallons Per Minute	Number of Stages: <u>2</u>

Pump Test Data	Method of Measuring Water Level Circle one
Date Well Tested: <u>7/18/17</u>	Air Line Electric Measuring Line <u>Steel Tape</u>
Static Water Level (A): <u>20</u> Feet Below Land Surface	Other (specify): _____
Pumping Water Level (B): <u>30</u> Feet Below Land Surface	For flowing well, measured shut in head: _____ feet
Drawdown [(B) - (A)]: <u>10</u> Feet Below Land Surface	Well yielded <u>2500</u> GPM with a drawdown of _____
Test Pumping Rate: <u>2500</u> Gallons Per Minute	<u>10</u> feet after <u>4</u> hours of pumping
Duration of Pump Test (minimum 4 hours): <u>4</u> hours	

I HEREBY CERTIFY that the above statements are true to the best of my knowledge.

TEDDY COATS #5318 Teddy Coats
 Print Name of Pump Installer and License No. (if applicable) Signature of Pump Installer