

State Well Report

Part I - Driller's Log

County: Panola
 Permit #: MS-LW-49699
 Driller: ~~12-5-16~~ TEODY COATS
 Date drilling completed: 12-5-16

Mississippi Department of Environmental Quality
 Office of Land and Water Resources
 P.O. Box 2309
 Jackson, MS 39225
 (601)961-5210
 (601)961-5228 (fax)

For Office Use Only:

Aquifer: _____
 Well #: K67
 L. S. Elevation: _____
 E-log #: _____

State Law requires that this report be prepared by the license holder responsible for the work and filed with the Department at the above address within 30 days of completion of drilling of the well or borehole.

<p style="text-align: center;">Information on Well Owner (Landowner if borehole is not for a water well)</p> <p>Owner Name: <u>Matts P J</u> Mailing Address: <u>90 Harbor Town Rd</u> <u>Benton Ky 42025</u> City State Zip Code Telephone No. () _____</p>	<p style="text-align: center;">Well or Borehole Location</p> <p>Latitude: <u>34° 24' 40" N</u> Longitude: <u>90° 10' 33" W</u> Method of Lat/Long (circle one): Conventional Survey, USGS quad, Hand-held GPS, Survey-grade GPS <u>SE 1/4 SW 1/4 Sec 05 Twn 08S Rng 09W</u> Distance Direction Nearest Town <u>2 Miles E of Sleazy</u></p>
--	--

Well / Borehole Data

Date drilling started: 12-5-16 Date drilling completed: 12-5-16 Hole depth: 115 Hole diameter: 28
 Location of the source of any surface water used for drilling: Nearest Well
 Method of dosing and volume of Chlorine used in drilling and development: _____
 Logs run (circle all applicable): No log run Electric Gamma Ray Density Sonic Neutron Other: _____
 Name of organization running log(s): _____
 Purpose of borehole (check one): Water Well Geotechnical/Geological Investigation Ground Source Heat Pump
 Seismic Survey Other (describe) _____

If drilling is not related to water well construction, skip the remainder of this block.

Purpose of Well (check one): Home Industrial Public Supply Irrigation Fish Culture Other: _____
 If a flowing well, method of flow regulation: Valve _____ Other (describe) _____
 Static Water Level: 20 feet above or below (circle one) land surface Date measured: 12-5-16
 Method of Measurement (circle one) steel tape electric tape air line other: _____
 Well depth: 115 Well grouted to a depth of _____ feet Type of grout (circle one): Neat Cement Bentonite Mix
 Casing length: 75 feet Casing diameter: 16 inches Type of casing: P.V.C
 Screen length: 40 feet Screen diameter: 16 inches Type of screen: P.V.C
 Screen slot size: 0.50 inches Setting depth: From 0 feet to 70 feet
 Type of completion (circle all applicable): Gravel packed Underreamed Telescoped Open hole Natural Development
 Other (describe): _____
 Top of lap pipe or reduction in casing: _____ feet. *If telescoped or more than one screen, describe on next page*

Form: OLWR-SWR-1A (04/08)



RECEIVED

JAN 10 2017

OLWR



34 24 40n 90 10 33W
near Crenshaw

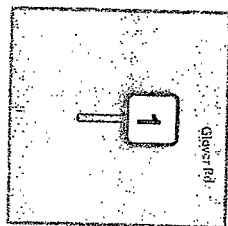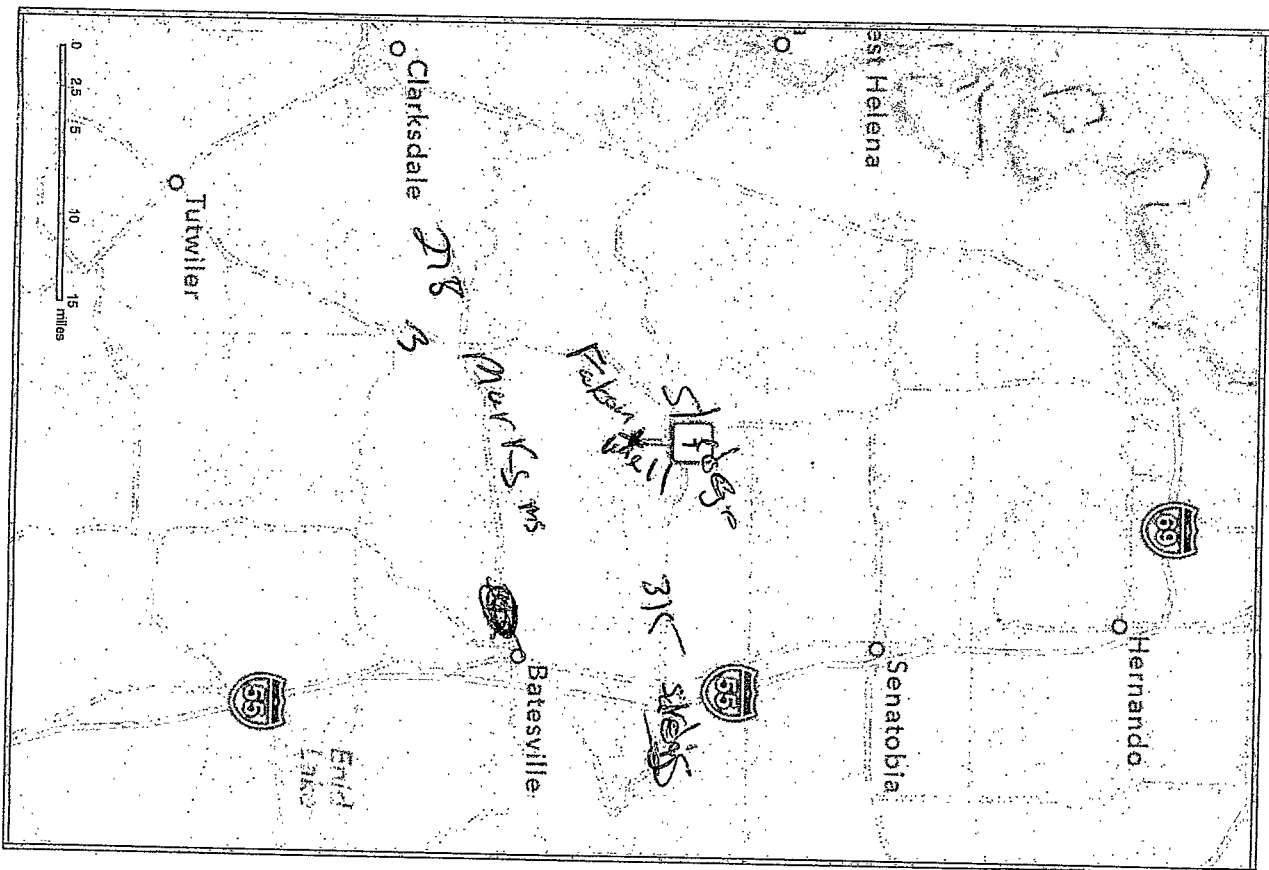

Crenshaw, MS 38621
Crenshaw, MS 38621
United States

Printed from myPhone

Page 1 of 1

RECEIVED

JAN 10 2007

BY CLWR

STATE WELL REPORT

Part 2

Pump Installer's Completion Report
 Mississippi Department of Environmental Quality
 Office of Land and Water Resources
 P.O. Box 2309
 Jackson, MS 39225
 (601)961-5210
 (601)961-5228 (fax)

County: Panola
 Permit #: MS. GW-49699
 Driller: TEDDY COATS
 Date completed: 12-5-16
Copy information from block on Part 1

For Office Use Only:

Aquifer: _____
 Well #: K67
 Elevation: _____

This part of the report must be completed by a licensed water well contractor or a licensed pump installer. A copy of Part 1 of the report must be attached and both parts filed with the Department at the above address within 30 days of well completion.

Well Owner Information	Well Location
Owner Name: <u>Matts P.J.</u>	Latitude: <u>34.2440 N</u> Longitude: <u>90 10 33 W</u>
Mailing Address: <u>90 Harbor Town Rd.</u>	Method of Lat/Long (check one): Conventional Survey _____
<u>Benton</u> <u>KY</u> <u>42025</u>	USGS quad _____, Hand-held GPS <input checked="" type="checkbox"/> , Survey-grade GPS _____
City State Zip Code	<u>SE 1/4 SW 1/4 Sec 05 T 08 S R 09 W</u>
Telephone No. () _____	Distance Direction Nearest Town
	<u>2</u> Miles <u>E</u> of <u>Sledge</u>

Pump Type Circle one	Power Type Circle one
Air Lift Jet Submersible	<u>Diesel Engine</u> Gasoline Engine Natural Gas
Bucket Piston <u>Turbine</u>	Electric Motor Hand Tractor PTO
Centrifugal Rotary Flowing Well	Windmill Other (specify): _____
Other (specify): _____	Horse Power Rating of Motor: <u>60 HP</u>
Date Pump Installed: <u>12-5-16</u>	Setting Depth: <u>0-70</u> feet
Rated Pump Capacity: <u>2500</u> Gallons Per Minute	Number of Stages: <u>2-Stage</u>

Pump Test Data	Method of Measuring Water Level Circle one
Date Well Tested: <u>12-5-16</u>	Air Line Electric Measuring Line <u>Steel Tape</u>
Static Water Level (A): <u>70</u> Feet Below Land Surface	Other (specify): _____
Pumping Water Level (B): <u>40</u> Feet Below Land Surface	For flowing well, measured shut in head: _____ feet
Drawdown [(B) - (A)]: <u>30</u> Feet Below Land Surface	Well yielded _____ GPM with a drawdown of _____ feet after _____ hours of pumping
Test Pumping Rate: <u>2500</u> Gallons Per Minute	
Duration of Pump Test (minimum 4 hours): <u>4</u> hours	

I HEREBY CERTIFY that the above statements are true to the best of my knowledge.

TEDDY COATS #5318 _____
 Print Name of Pump Installer and License No. (if applicable) Signature of Pump Installer

Form: OLWR-SWR-1B (04/08)

RECEIVED
 JAN 10 2017
 BY OLWR