

Panola

K 2000
7-3-80
7-3

MISSISSIPPI
BOARD OF WATER COMMISSIONERS
416 North State Street
Jackson, Mississippi 39201

WATER WELL DRILLERS LOG

1980 LiPe Well Co. Panola
date well completed firm name county well located

LANDOWNER:
SON Harris
Creusshaw MS.
(mailing address)

description of formations encountered	from	to
<u>TOP soil</u>	<u>0</u>	<u>20</u>
<u>sand</u>	<u>20</u>	<u>60</u>
<u>sand and gravel</u>	<u>60</u>	<u>110</u>

WELL LOCATION:
sec 2 T 8 N R 2 W
5 miles S. E. of Creusshaw
(distance) (direction) (nearest town)

WELL PURPOSE:
(home) irrigation, municipal, industrial


- WELL COMPLETION DATA:
- (1) diameter (inches) 4
 - (2) total depth (feet) 110
 - (3) static water level (feet) 15 below top of ground.
 - (4) casing PVC 100
(material) (depth)
4 if telescope see back.
(size)
 - (5) screen 10 100
(length) (depth to top)
4 PVC
(size) (material)
 - (6) pump 3/4 10
(HP) (yield gpm)
elec.
(type power)
 - (7) electric log NO
(yes or no)
N/A
(organization running log)
 - (8) how well bottom plugged PVC
cap

DRILLERS REMARKS:

DEPT. OF NATURAL RESOURCES
BUREAU OF LAND & WATER RESOURCES
JUL 17 1980
RECEIVED

If well telescopes please sketch and show depths.

GROUND LEVEL

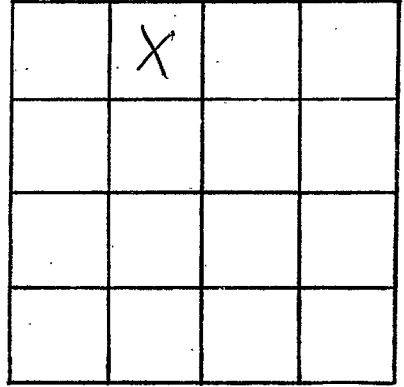

SECTION 2

Please indicate well location X.

ADDITIONAL INFORMATION

If more than one screen,
show locations of each on sketch.