

BOARD OF WATER COMMISSIONERS

416 North State Street

Jackson, Mississippi 39201

*Parade*  
K 2001

WATER WELL DRILLERS LOG

9/1/83

date well completed

19 *Lipe Well Supply*

firm name

*Parade*

county well located

LANDOWNER: *Windward Mt. Rest*

Description of formations encountered

from

to

*Top soil clay*  
*SAND GRAVEL*  
*White clay*  
*SAND*

*0 15*  
*15 90*  
*90 120*  
*120 200*

(mailing address)

WELL LOCATION:

sec. 8 T. 8 N. R. 9 E  
*10* miles *West* of *Scarb's*  
(distance) (direction) (nearest town)

WELL PURPOSE: *home*  
(home, irrigation, municipal, industrial)

WELL COMPLETION DATA:

- (1) diameter (inches) 4 1/2
- (2) total depth (feet) 200
- (3) static water level (feet) 8.5 below above top of ground.
- (4) casing PVC, 142,  
(material) (depth)  
4 1/2 if telescope see back.  
(size)
- (5) screen 8, 142  
(length) (depth to top)  
4, PVC  
(size) (material)
- (6) pump 3/4, 10  
(HP) (yield gpm)  
elec  
(type power)
- (7) electric log No  
(yes or no)

(organization running log)

(8) how well bottom plugged PVC  
cap

DRILLERS REMARKS:


DEPT. OF NATURAL RESOURCES  
BUREAU OF LAND & WATER RESOURCES

SEP 20 1983

RECEIVED

If well telescopes please  
sketch and show depths.

GROUND LEVEL

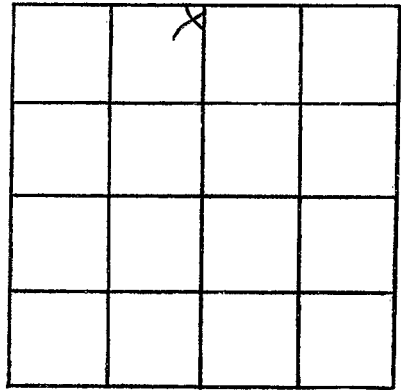

SECTION \_\_\_\_\_

Please indicate well location X.

ADDITIONAL INFORMATION

If more than one screen,  
show locations of each on sketch.