

WATER WELL DRILLERS LOG

L
9-1-63

Date: 9-1, 1963, Driller: J B CAIN County: Panola

(Name)

(1) Owner of Land: M Barnett
Balesville Miss
(Name)
(Address)

Description & Color of Materials
Sand, Clay, Red Clay, Shell, etc.

Thick-
ness
Feet
Depth
Feet
0 40
40 95

(2) Location: 1/4, 1/4, Sec. T R,
8 miles N.W. of BATESVILLE
(distance) (direction) (Nearest Town)

(3) Topography: (Hilly) (Flat) (Level)

(4) Purpose of Well: Home
(Domestic Irrigation
Municipal, Industrial, Other)

Information upon completion of well:

(1) Diameter 2 inches.

(2) Total Depth 95 feet.

(3) Water Level 80 feet below top of ground.

(4) Cased to 95, Size 2"


(5) Screen: Size 3", Length 5
Plastic well +
screen

(6) Were any formations sealed against pollution?
_____ yes, _____ no.

If YES depth of formation _____

Why _____

Drillers Remarks:
Plastic well
+ screen

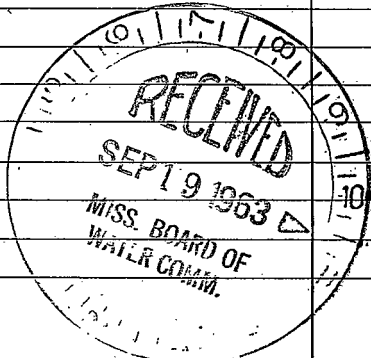

(Use Back Side)

Well No.

