

L
11-7-63

WATER WELL DRILLERS LOG

Date: 10-7, 1963, Driller: J B Carr County Panola
(Name)

(1) Owner of Land	Description & Color of Materials Sand, Clay, Red Clay, Shell, etc.	Thick- ness Feet	Depth Feet
<u>M J Burnett</u> (Name) <u>Batesville</u> (Address)	<u>Bro of</u> <u>sand</u>	<u>0</u> <u>30</u>	<u>30</u> <u>55</u>
(2) Location: <u>1/4</u> , <u>1/4</u> , Sec. <u>T</u> , <u>R</u>			
<u>10</u> miles <u>N-W</u> of <u>Batesville</u> (distance) (direction) (Nearest Town)			
(3) Topography: <input checked="" type="checkbox"/> (Hilly) <input type="checkbox"/> (Flat) <input type="checkbox"/> (Level)			
(4) Purpose of Well: <u>Home</u> (Domestic Irrigation Municipal, Industrial, Other)			

Information upon completion of well:

(1) Diameter 4 inches.

(2) Total Depth 55 feet.

(3) Water Level 40 feet below top of ground.

(4) Cased to 55, Size 4"


(5) Screen: Size 4", Length 5 FT

(6) Were any formations sealed against pollution?
_____ yes, _____ no.

If YES depth of formation _____

Why _____

Drillers Remarks: _____

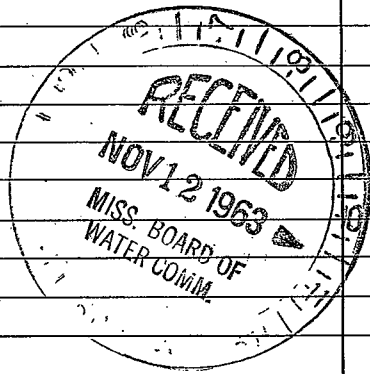

(Use Back Side)

Well No.

