

PANOLA MISSISSIPPI BOARD OF WATER COMMISSIONERS

L
3-3-66

WATER WELL DRILLERS LOG


Date 3-3, 1966, Driller: J B Cain County Panola
(Name)

	Description & Color of Materials Sand, Clay, Red Clay, Shell, etc.	Thick- ness Feet	Depth Feet
(1) Owner of Land: <u>Mr Weather</u> (Name) <u>Batesville, Miss</u> (Address)	<u>Bron Clay</u>	<u>0</u>	<u>30</u>
(2) Location: <u>1/4</u> , <u>1/4</u> , Sec. <u>T</u> , <u>R</u>	<u>Shale & Sand</u>	<u>30</u>	<u>95</u>
<u>5</u> miles <u>N-W</u> of <u>Batesville</u> (distance) (direction) (Nearest Town)	<u>Gray Clay</u>	<u>95</u>	<u>110</u>
(3) Topography: <input checked="" type="checkbox"/> (Hilly) <input type="checkbox"/> (Flat) <input type="checkbox"/> (Level)	<u>Sand</u>	<u>110</u>	<u>230</u>
(4) Purpose of Well: <u>Home</u> (Domestic Irrigation Municipal, Industrial, Other)			

Information upon completion of well:

- (1) Diameter 4 inches.
- (2) Total Depth 230 feet.
- (3) Water Level 128 feet below top of ground.
- (4) Cased to 230, Size 4"
- (5) Screen: Size 3/8", Length 5 FT
- (6) Were any formations sealed against pollution?
no.

If YES depth of formation _____
Why _____
Drillers Remarks: _____

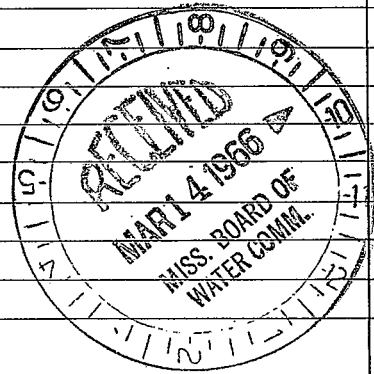

(Use Back Side)

Well No.

