

Panola
 L1
 6-67
 Misses Sur.
 June 1967
 date well completed

MISSISSIPPI
 BOARD OF WATER COMMISSIONERS
 416 North State Street
 Jackson, Mississippi 39201

CODED

WATER WELL DRILLERS LOG
 Robert E. Lally Co.
 firm name

Panola
 county well located

LANDOWNER: Guzzo
Gravel Co.
Sardis Miss.
 (mailing address)

WELL LOCATION:
 sec. 14 T. 8 N. R. 8 E.
14 miles SW of Sardis
 (distance) (direction) (nearest town)

WELL PURPOSE: Industrial
 (home, irrigation, municipal, industrial)

WELL COMPLETION DATA:

(1) diameter (inches) 14"

(2) total depth (feet) 240

(3) static water level (feet) 50 ^{below}/_{above} top of ground.

(4) casing St. 200'
 (material) (depth)

14"
 (size) if telescope see back.

(5) screen 40' 200'
 (length) (depth to top)

14" St St.
 (size) (material)

(6) pump 40 500
 (HP) (yield gpm)

electric
 (type power)


(7) electric log Yes
 (yes or no)

M. S. S.
 (organization running log)

(8) how well bottom plugged BPU

description of formations encountered	from	to
Top Soil	0	20
Top Soil, sand streaks	20	30
sand, clay streaks	30	40
Sand	40	50
sand, clay streaks	50	60
white clay, sand streaks	60	70
Sand	70	80
Sand & Rock	80	90
Clay	90	110
Hard Clay	110	130
Clay	130	158
Sand	158	166
Clay	166	171
Clay, sand streaks	171	181
Sand, clay streaks	181	191
Sand	191	216
Rocks, sandy shale	216	221
Sandy Shale	221	231

CODED

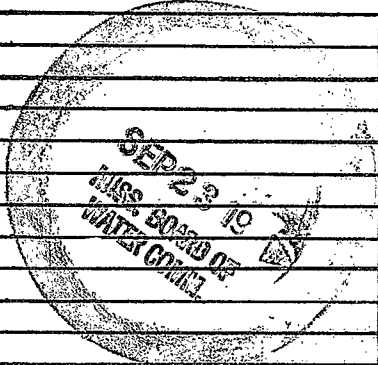

DRILLERS REMARKS:

If well telescopes please sketch and show depths.

GROUND LEVEL

SECTION _____

Please indicate well location X.

ADDITIONAL INFORMATION

If more than one screen, show locations of each on sketch.