

**CODED**

**WATER WELL DRILLERS LOG**

*R L 4*  
*2-25-64*

Date: *Feb. 25, 1964*, Driller: *Frank Taylor* County: *Panola*  
(Name)

(1) Owner of Land: *Frank Thomas*  
(Name)  
*Batesville*  
(Address)

(2) Location:  $\frac{1}{4}$ ,  $\frac{1}{4}$ , Sec. *26 T 8 R 8*  
*SW*  
*8* miles *N.W.*, of *Batesville*  
(distance) (direction) (Nearest Town)

(3) Topography: *Hilly*  
(Hilly) (Flat) (Level)

(4) Purpose of Well: *Domestic*  
(Domestic Irrigation  
Municipal, Industrial, Other)

Description & Color of Materials Sand, Clay, Red Clay, Shell, etc.	Thick- ness Feet	Depth Feet
<i>white clay</i>	<i>0</i>	<i>110</i>
<i>white sandy sand</i>	<i>110</i>	<i>119</i>


Information upon completion of well:

- (1) Diameter *2* inches.
- (2) Total Depth *119* feet.
- (3) Water Level *100* feet below top of ground.
- (4) Cased to *105*, Size *2*.
- (5) Screen: Size *1/4*, Length *6'*.
- (6) Were any formations sealed against pollution?  
\_\_\_\_\_ yes, \_\_\_\_\_ no.

If YES depth of formation \_\_\_\_\_  
Why \_\_\_\_\_

Drillers Remarks: \_\_\_\_\_  
\_\_\_\_\_  
\_\_\_\_\_

**CODED**

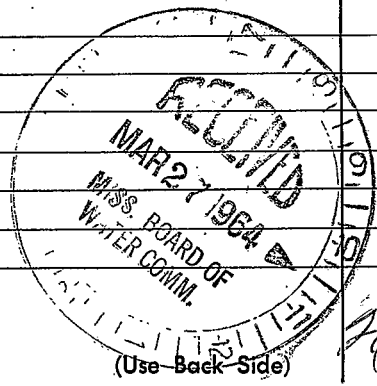

Well No. *He*

100