

PANOLA
R L 5
10-3-64

WATER WELL DRILLERS LOG

CODED

Date: 10-3, 1964, Driller: Frank Taylor ^{Life} County Panola
(Name)

(1) Owner of Land: All Buck
(Name)
Batesville
(Address)

(2) Location: $\frac{1}{4}$, $\frac{1}{4}$, Sec 28 T 8 R 8
SW
10 miles N. West of Batesville
(distance) (direction) (Nearest Town)

(3) Topography: Hilly
(Hilly) (Flat) (Level)

(4) Purpose of Well: Dom.
(Domestic Irrigation, Municipal, Industrial, Other)

Description & Color of Materials Sand, Clay, Red Clay, Shell, etc.	Thick- ness Feet	Depth Feet
<u>Clay</u>	<u>0</u>	<u>40</u>
<u>Red clay</u>	<u>40</u>	<u>75</u>
<u>Gravel</u>	<u>75</u>	<u>105</u>
<u>Gravel sand</u>	<u>105</u>	<u>127</u>

Information upon completion of well:

(1) Diameter 2 inches.

(2) Total Depth 126' feet.

(3) Water Level 80 feet below top of ground.

(4) Cased to 127, Size 2 1/2.

(5) Screen: Size 1 1/4, Length 6'.


(6) Were any formations sealed against pollution?
_____ yes, _____ no.

CODED

If YES depth of formation _____

Why _____

Drillers Remarks: _____

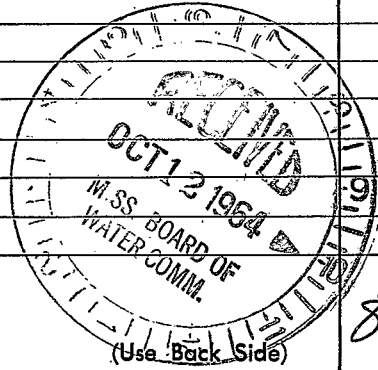

Well No. 8

1111

1111