

PANOLA
 L 6
 3-68

MISSISSIPPI
 BOARD OF WATER COMMISSIONERS
 416 North State Street
 Jackson, Mississippi 39201

CODED
 CODED

WATER WELL DRILLERS LOG

March 21, 1968 date well completed
 Y. R. Lips firm name
 Panola county well located

LANDOWNER:
 Mrs. Fred Ferrell
 Batesville Miss.
 (mailing address)


description of formations encountered	from	to
TOP SOIL	0	20
Sand and clay	20	40
Sand and gravel	40	60
Gravel	60	80
Clay and sand	80	100
Clay and sand	100	120
Water sand	120	140
	140	160

WELL LOCATION:
 sec. 28 T. 81 N. R. 5 W. E.
 7 miles (distance) N. West of Batesville (direction) (nearest town)

WELL PURPOSE:
 (home, irrigation, municipal, industrial)

- WELL COMPLETION DATA:
- (1) diameter (inches) 4
 - (2) total depth (feet) 160
 - (3) static water level (feet) _____ below top of ground.
 - (4) casing (material) Plastic, 1 1/2" (depth) 146
 4" if telescope see back. (size)
 - (5) screen 14" (length) 146" (depth to top)
 4" (size) Great-purified (material)
 - (6) pump 7 1/2 (HP) 1.0 (yield gpm)
 elec. (type power)
 - (7) electric log Yes (yes or no)

CODED

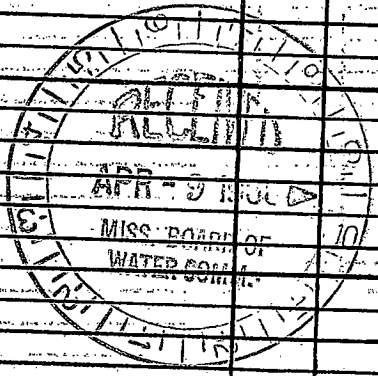


(organization running log)
 (8) how well bottom plugged Clay

DRILLERS REMARKS:

If well telescopes please sketch and show depths.

GROUND LEVEL

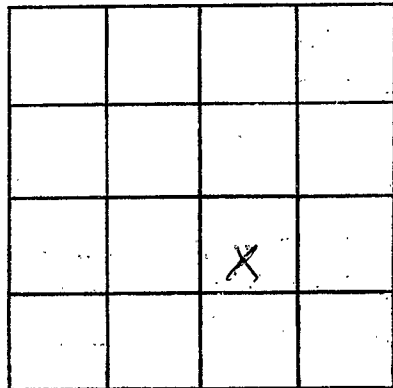

SECTION 28

Please indicate well location X.

ADDITIONAL INFORMATION

If more than one screen,
show locations of each on sketch.