

CODED

MISSISSIPPI
BOARD OF WATER COMMISSIONERS
416 North State Street
Jackson, Mississippi. 39201

WATER WELL DRILLERS LOG

PANOLA
L 7
3-68

3-22 1968 James R. Gipe Panola
date well completed firm name county well located

LANDOWNER:
Jimmie Brown
Batesville, Miss.
(mailing address)

description of formations encountered	from	to
TOP soil	0	20
Sand and gravel	20	40
Sand and clay	40	60
water sand	60	88

WELL LOCATION:
sec. 33 T. 85 N R. 8 W E
6 miles West of Batesville
(distance) (direction) (nearest town)


WELL PURPOSE:
(home, irrigation, municipal, industrial)

- WELL COMPLETION DATA:
- (1) diameter (inches) 2
 - (2) total depth (feet) 88
 - (3) static water level (feet) 60 below above top of ground.
 - (4) casing galv. 82
(material) (depth)
 - _____ if telescope see back.
(size)
 - (5) screen 6 82
(length) (depth to top)
 - 2 galv.
(size) (material)
 - (6) pump 1/2 3
(HP) (yield gpm)
 - elec.
(type power)
 - (7) electric log no
(yes or no)

(organization running log)

(8) how well bottom plugged strainer
on end

DRILLERS REMARKS:

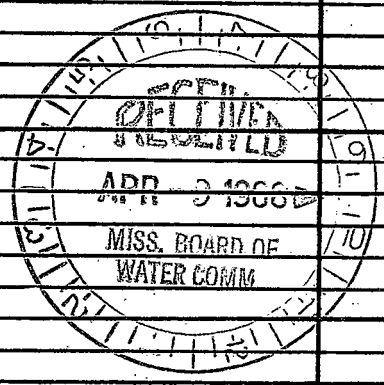

If well telescopes please sketch and show depths.

GROUND LEVEL

		X	

SECTION 33

Please indicate well location X.

ADDITIONAL INFORMATION

If more than one screen, show locations of each on sketch.