

CODED

MISSISSIPPI
BOARD OF WATER COMMISSIONERS
416 North State Street
Jackson, Mississippi 39201

WATER WELL DRILLERS LOG

Panola
L 8
12-68

1968 James R. Life Panola

date well completed

firm name

county well located

LANDOWNER: Cleaveland Doyle
Batesville
Miss.
(mailing address)

description of formations encountered

from

to

Clay 0 20
Clay and sand 20 40
Gravel 40 60
Gravel and sand 60 80
Sand 80 90

WELL LOCATION:

sec. 33 T. 8 N. R. 8 E.
5 miles West of Batesville
(distance) (direction) (nearest town)

WELL PURPOSE: HOME
(home, irrigation, municipal, industrial)

WELL COMPLETION DATA:

- (1) diameter (inches) 2"
- (2) total depth (feet) 90
- (3) static water level (feet) 30 below above top of ground.
- (4) casing Galv. 84
(material) (depth)
(size) if telescope see back.
- (5) screen 6 84
(length) (depth to top)
1/4 Galv.
(size) (material)
- (6) pump 1/2 3
(HP) (yield gpm)
Elec.
(type power)
- (7) electric log NO
(yes or no)

(organization running log)

(8) how well bottom plugged with point

DRILLERS REMARKS:

CODED


JAN - 2 1968

MISS. Bd. OF WATER COMMISSIONERS

MISS. Bd. OF WATER COMMISSIONERS

If well telescopes please sketch and show depths.

GROUND LEVEL

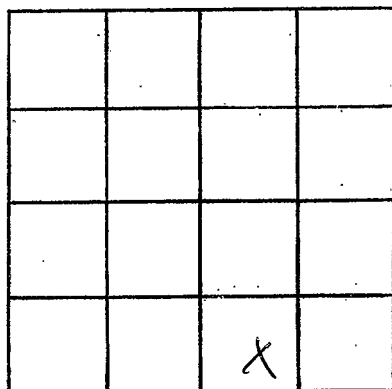

SECTION 33

Please indicate well location X.

ADDITIONAL INFORMATION

If more than one screen,
show locations of each on sketch.