

CODED

PANOLA
L 10
-69

MISSISSIPPI
BOARD OF WATER COMMISSIONERS
15E 416 North State Street
Jackson, Mississippi 39201

WATER WELL DRILLERS LOG

19 LIFE WELL CO. firm name PANOLA county well located
date well completed

LANDOWNER:	description of formations encountered	from	to
<u>Willie Deaton</u>	<u>top soil - gravel</u>	<u>0</u>	<u>20</u>
	<u>gravel - sand</u>	<u>20</u>	<u>40</u>
	<u>sand</u>	<u>40</u>	<u>60</u>
(mailing address)	<u>sand</u>	<u>60</u>	<u>80</u>
WELL LOCATION:	<u>sand</u>	<u>80</u>	<u>100</u>
sec. <u>28</u> T <u>8</u> N R <u>8</u> E	<u>sand</u>	<u>100</u>	<u>120</u>
(S) (W)	<u>sand</u>	<u>120</u>	<u>140</u>
<u>6</u> miles <u>NW</u> of <u>Batesville</u>	<u>sand</u>	<u>140</u>	<u>163</u>
(distance) (direction) (nearest town)			
WELL PURPOSE: <u>home</u> (home, irrigation, municipal, industrial)			
WELL COMPLETION DATA:			
(1) diameter (inches) <u>4"</u>			
(2) total depth (feet) <u>163'</u>			
(3) static water level (feet) _____ below above top of ground.			
(4) casing <u>PVC</u> <u>155'</u> (material) (depth)			
<u>4"</u> (size) if telescope see back.			
(5) screen <u>8'</u> <u>155'</u> (length) (depth to top)			
<u>4"</u> <u>PVC & silica</u> (size) (material)			
(6) pump <u>3/4 HP</u> <u>10</u> (HP) (yield gpm)			
<u>Elec.</u> (type power)			
(7) electric log <u>NO</u> (yes or no)			
(organization running log)			
(8) how well bottom plugged <u>PVC</u> <u>cap</u>			

CODED


NOV 14 1969

MISS. BD. OF
WATER COMMISSIONERS

DRILLERS REMARKS:

If well telescopes please sketch and show depths.

GROUND LEVEL

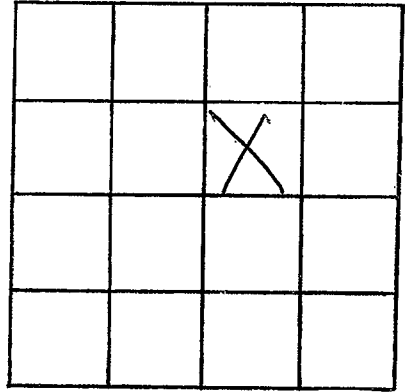

SECTION 28

Please indicate well location X.

ADDITIONAL INFORMATION

Lined area for additional information.

If more than one screen, show locations of each on sketch.