

Panola
L 11
6-2-70

MISSISSIPPI
BOARD OF WATER COMMISSIONERS
416 North State Street
Jackson, Mississippi 39201

CODED

WATER WELL DRILLERS LOG

6-2-70 date well completed
J. B. Cain firm name
Panola county well located

LANDOWNER

M. Craig
Batesville
Miss
(mailing address)

description of formations encountered

Brk of
Sand

from

to

0 10

10 40

WELL LOCATION:

sec 36 T 8 N R 8 E
3 miles W of Batesville
(distance) (direction) (nearest town)

WELL PURPOSE:

(home, irrigation, municipal, industrial)

WELL COMPLETION DATA:

(1) diameter (inches) 2
(2) total depth (feet) 40
(3) static water level (feet) 15 below top of ground

(4) casing Plastic 35
(material) (depth)
(size) if telescope see back.

(5) screen 5 35
(length) (depth to top)
2 Plastic Sand
(size) (material)

(6) pump 6
(HP) (yield gpm)
(type power)

(7) electric log
(yes or no)
(organization running log)

(8) how well bottom plugged Plugged

CODED


JUN 22 1978

MISS. BD. OF
WATER COMM.

DRILLERS REMARKS:

If well telescopes please sketch and show depths.

GROUND LEVEL

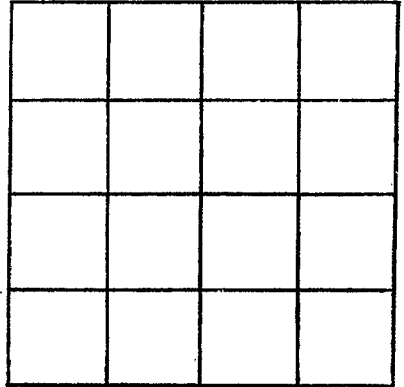

SECTION _____

Please indicate well location X.

ADDITIONAL INFORMATION

If more than one screen, show locations of each on sketch.