

*Lost*

PANOLA  
L 14  
11-71

MISSISSIPPI  
BOARD OF WATER COMMISSIONERS  
416 North State Street  
Jackson, Mississippi 39201

**CODED**

WATER WELL DRILLERS LOG

*T.B. Co. Big Stream*  
*James W. T. S.* Panola  
date well completed 19            firm name            county well located

LANDOWNER: James White

description of formations encountered from to

(mailing address)

WELL LOCATION:

sec. 21 T. 8 N. R. 8 E  
S.            W.           

miles            of            (distance) (direction) (nearest town)

WELL PURPOSE:

(home, irrigation, municipal, industrial)

WELL COMPLETION DATA:

(1) diameter (inches) 2"

(2) total depth (feet) 170

(3) static water level (feet) 85' below            top of ground. above

(4) casing Plastic 170,  
(material) (depth)

           If telescope see back.  
(size)

(5) screen 10 160  
(length) (depth to top)

2" Plastic  
(size) (material)

(6) pump            4  
(HP) (yield gpm)

            
(type power)

(7) electric log             
(yes or no)

            
(organization running log)

(8) how well bottom plugged           


DRILLERS REMARKS:           

Sand & sandy clay 0 100  
Gravel 100 75  
Sand 75 170

**CODED**

If well telescopes please sketch and show depths.

GROUND LEVEL

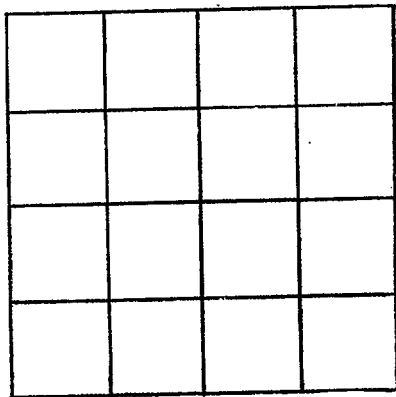

SECTION \_\_\_\_\_

Please indicate well location X.

ADDITIONAL INFORMATION

If more than one screen,  
show locations of each on sketch.