

Panola
L 17
4-68

MISSISSIPPI
 BOARD OF WATER COMMISSIONERS
 416 North State Street
 Jackson, Mississippi 39201

CODED

WATER WELL DRILLERS LOG

April 26 19 *1968* *Robison + Son* firm name *Panola* county well located

LANDOWNER: *Tom Cooper*
Batesville, Miss
 (mailing address)
 WELL LOCATION:
 sec. *3* / T. *8* N R. *3* E
4 miles *SW* of *B'ville*
 (distance) (direction) (nearest town)

description of formations encountered	from	to
<i>Red Clay</i>	<i>0</i>	<i>20</i>
<i>white clay</i>	<i>20</i>	<i>40</i>
<i>sand & clay</i>	<i>40</i>	<i>60</i>
<i>white sand</i>	<i>60</i>	<i>90</i>

WELL PURPOSE: *home*
 (home, irrigation, municipal, industrial)

- WELL COMPLETION DATA:
- (1) diameter (inches) *2"*
 - (2) total depth (feet) *90*
 - (3) static water level (feet) *60* below above top of ground.
 - (4) casing *steel* *85'*
 (material) (depth)
 - 2"*
 (size) if telescope see back.
 - (5) screen *5 ft* *85'*
 (length) (depth to top)
 - 1 1/2"* *brass*
 (size) (material)
 - (6) pump *3/4* *3*
 (HP) (yield gpm)
 - EVA 110*
 (type power)
 - (7) electric log *no*
 (yes or no)
 - (organization running log)
 - (8) how well bottom plugged *Sealed*


CODED

JUL 26 1968
 MISS. BOARD OF
 WATER COMMISSIONERS

DRILLERS REMARKS: *steel well*

If well telescopes please sketch and show depths.

GROUND LEVEL

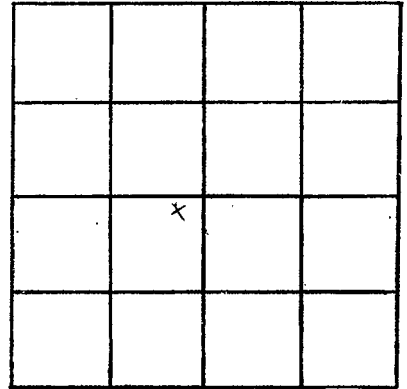

SECTION 31

Please indicate well location X.

ADDITIONAL INFORMATION

If more than one screen, show locations of each on sketch.