

Panola
L 18
8-6-73

MISSISSIPPI
 BOARD OF WATER COMMISSIONERS
 416 North State Street
 Jackson, Mississippi 39201

CODED

WATER WELL DRILLERS LOG

8-6 1973 JAMES R. Lipe Panola
 date well completed firm name county well located

LANDOWNER:
FLOYD WILLIAMS
Batesville Miss.
 (mailing address)

description of formations encountered	from	to
Top soil	0	20
red sand	20	40
" "	40	60
gravel	60	80
" "	80	100
sand and gravel	100	120
white sand	120	181

WELL LOCATION:
 sec. 35 T 8 N R 3
7 miles N.W. of Batesville
 (distance) (direction) (nearest town)

WELL PURPOSE:
 (home) irrigation, municipal, industrial

- WELL COMPLETION DATA:
- (1) diameter (inches) 4
- (2) total depth (feet) 181
- (3) static water level (feet) 105 below top of ground.
- (4) casing PVC, 171
 (material) (depth)
4 if telescope see back.
 (size)
- (5) screen 10, 171
 (length) (depth to top)
4, PVC
 (size) (material)
- (6) pump 3/4, 10
 (HP) (yield gpm)
elec.
 (type power)
- (7) electric log NO
 (yes or no)
NO
 (organization running log)
- (8) how well bottom plugged PVC
plug


CODED

SEP 6 1973

DRILLERS REMARKS:

If well telescopes please sketch and show depths.

GROUND LEVEL

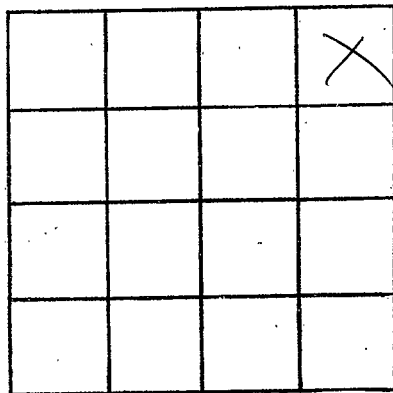

SECTION 35

Please indicate well location X.

ADDITIONAL INFORMATION

If more than one screen, show locations of each on sketch.