

PANOLA
L 22
6-10-73

MISSISSIPPI
BOARD OF WATER COMMISSIONERS
416 North State Street
Jackson, Mississippi 39201

CODED

WATER WELL DRILLERS LOG

June 10 1973 J B Cain Panola
date well completed firm name county well located

LANDOWNER: Ma Jewels

description of formations encountered	from	to
	Clay	0
Gravel	40	105
Red Sand	105	140
W Sand	140	170

(mailing address)

WELL LOCATION:
sec 25 T 8 N R 1 E
SW NW
5 miles W of Batesville
(distance) (direction) (nearest town)

WELL PURPOSE: Home
(home, irrigation, municipal, industrial)

WELL COMPLETION DATA:

- (1) diameter (inches) 4"
- (2) total depth (feet) 170
- (3) static water level (feet) 130 below above top of ground.
- (4) casing Plastic, 170,
(material) (depth)
____ if telescope see back.
(size)
- (5) screen 10', 160
(length) (depth to top)
4", Plastic
(size) (material)
- (6) pump 3/4 11
(HP) (yield gpm)
Electric
(type power)
- (7) electric log no
(yes or no)

(organization running log)
- (8) how well bottom plugged Plug

CODED


REC 27 107

DRILLERS REMARKS:

Miss. Bd. of
Water Comm.

If well telescopes please sketch and show depths.

GROUND LEVEL

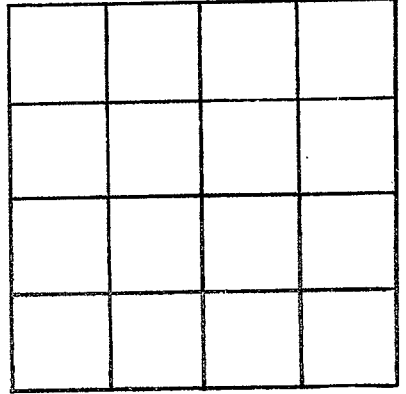

SECTION _____

Please indicate well location X.

ADDITIONAL INFORMATION

If more than one screen, show locations of each on sketch.