

PANOLA

L27

1-24-74

MISSISSIPPI BOARD OF WATER COMMISSIONERS
416 North State Street
Jackson, Mississippi 39201

CODED

WATER WELL DRILLERS LOG

Jan 24 1974
date well completed

J.B. Cain Panola
firm name county well located
(Big Stream)

LANDOWNER: Mrs. Martin

description of formations encountered

from to

(mailing address)

WELL LOCATION:

sec. 26 T. 8 N. R. 3 E. S. 3 W.
5 miles N-W of Waterville
(distance) (direction) (nearest town)

Clay & Sand 8 46
Sand 47 160

WELL PURPOSE:

(home, irrigation, municipal, industrial)

WELL COMPLETION DATA:

(1) diameter (inches) 4"
(2) total depth (feet) 160
(3) static water level (feet) 40 below top of ground.

CODED

(4) casing Plastic 160
(material) (depth)

(size) If telescope see back.

(5) screen 10' 15'
(length) (depth to top)
4" Plastic
(size) (material)

(6) pump 3/4 10
(HP) (yield gpm)

Elec
(type power)

(7) electric log No
(yes or no)

(organization running log)


(8) how well bottom plugged Plug

DRILLERS REMARKS:

MAR 20 1974

If well telescopes please sketch and show depths.

GROUND LEVEL

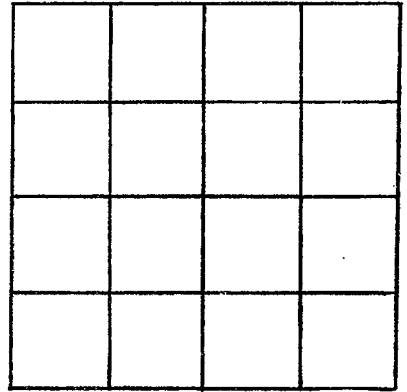

SECTION _____

Please indicate well location X.

ADDITIONAL INFORMATION

If more than one screen,
show locations of each on sketch.